



UNNAMED CREEK  
CHELASIE M/L  
km 1+500 - AS BUILT



ALLNORTH  
CONSULTANTS  
LIMITED

301-1777 THIRD AVE.  
PRINCE GEORGE  
B.C. V6L 2G1

reproduction scale  
10 20 30

plot date: 2001/01/16

scale

drawn

design

checked

map ref.

revision

sheet no.



of

drawing no.

00-C-211

filename: 00C211-T.DWG

| no. | date | by | eng. | subject |
|-----|------|----|------|---------|
|     |      |    |      |         |

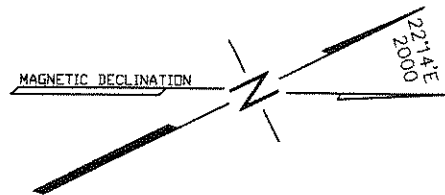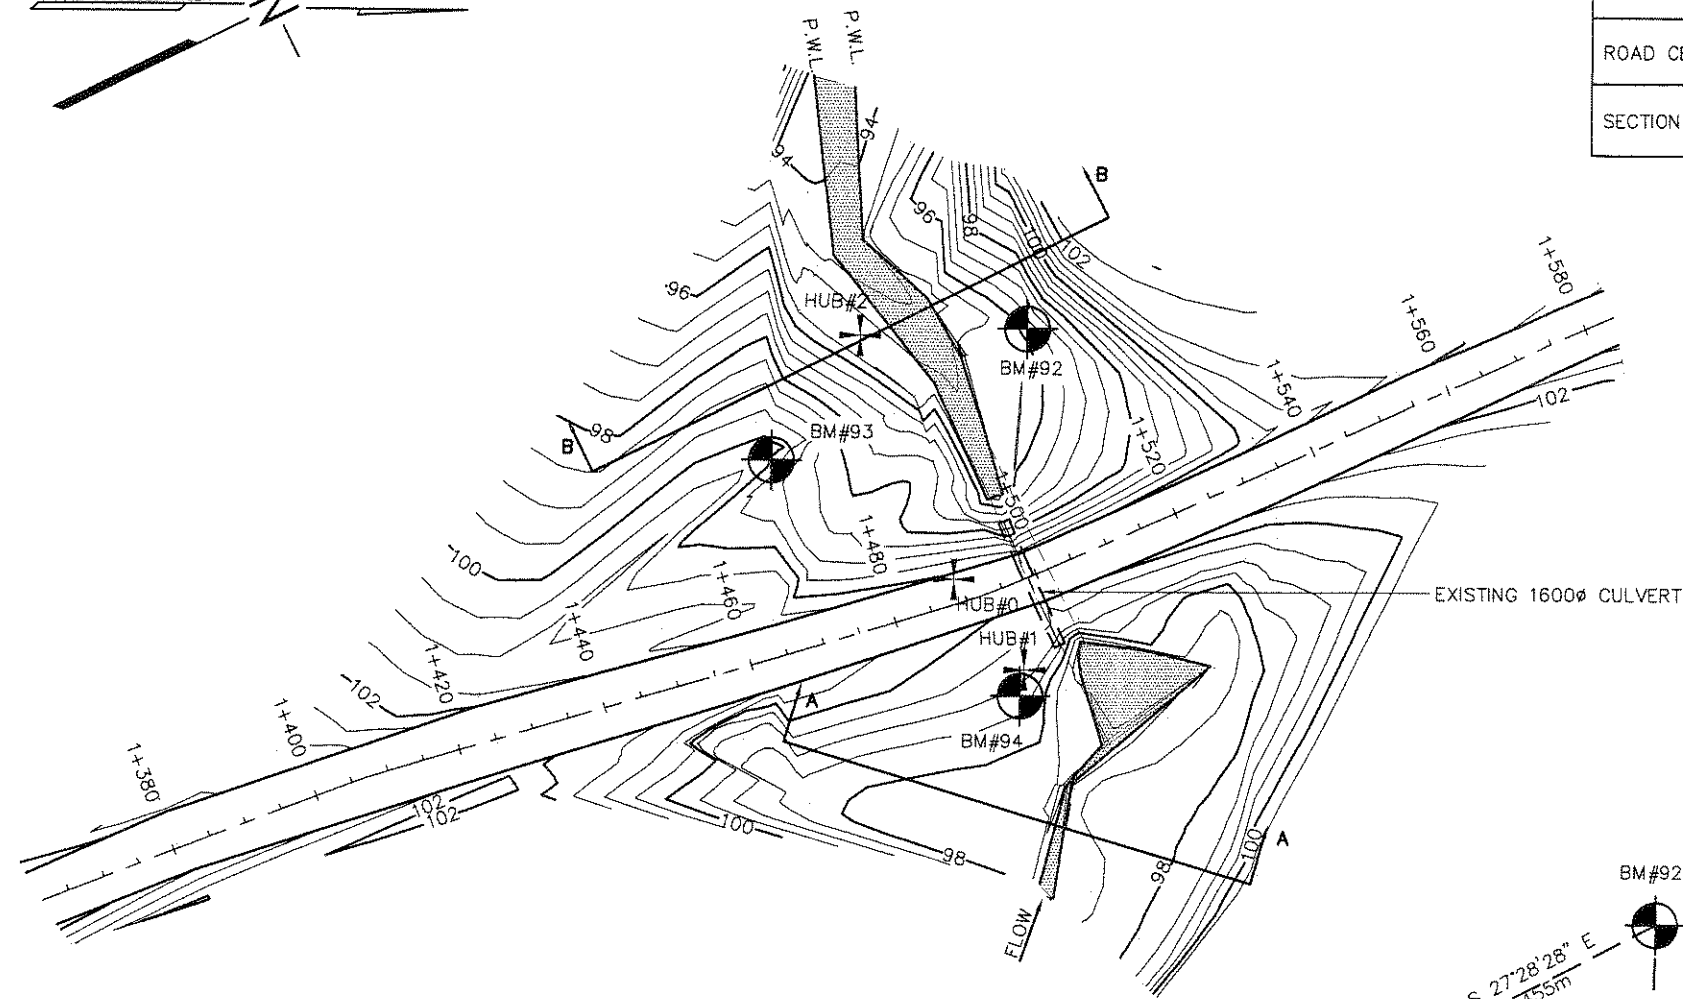


SITE PLAN


| STREAMBED COMPOSITION |                                                            |
|-----------------------|------------------------------------------------------------|
| SECTION A-A           | 30% 0-5mmØ<br>30% 5-50mmØ<br>10% 50-250mmØ<br>30% > 250mmØ |
| ROAD CENTER           |                                                            |
| SECTION B-B           |                                                            |

SURVEY INFORMATION:

|       | ELEVATION | NORTHING | EASTING  |
|-------|-----------|----------|----------|
| BM#92 | 96.652    | 5009.604 | 4966.618 |
| BM#93 | 100.173   | 4975.470 | 4984.329 |
| BM#94 | 99.015    | 5008.976 | 5015.508 |
| HUB#0 | 100.000   | 5000.000 | 5000.000 |
| HUB#1 | 99.270    | 5009.551 | 5012.015 |
| HUB#2 | 95.130    | 4987.137 | 4967.664 |

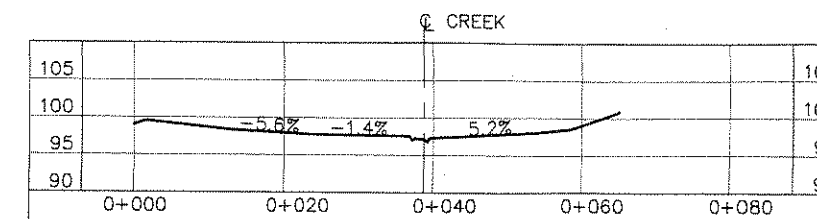

SECTION A-A

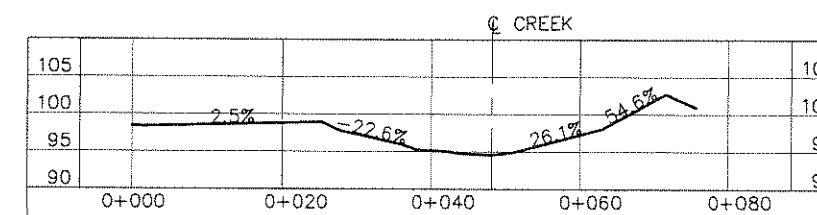

SECTION B-B

UNNAMED CREEK  
CHELASLIE M/L  
km 1+500  
AS BUILT

SITE PLAN  
PROFILES &  
HYDROLOGY



ALLNORTH  
CONSULTANTS  
LIMITED


301-1777 THIRD AVE.  
PRINCE GEORGE  
B.C. V6B 2Z9

SITE NOTES:


1. SITE PLAN WAS COMPLETED ON 2000/06/21.
2. SURVEY DATA WAS ESTABLISHED USING NO DECLINATION.
3. SITE SURVEYOR: D. NORMAN
4. STREAM RIPARIAN CLASSIFICATION: S3.
5. DOMINANT RIPARIAN DESCRIPTION: SPRUCE.
6. HYDROLOGY:
  - DRAINAGE AREA=35km<sup>2</sup>
  - Q100I FLOW IS ESTIMATED @ 13.8m<sup>3</sup>/s
  - VELOCITY IS ESTIMATED @ 2.3m/s
7. SUGGESTED BRIDGE SPAN IS 12.192m
8. NO GEOTECHNICAL REPORT HAS BEEN COMPLETED TO DATE.

|     |       |    |      |                                 |
|-----|-------|----|------|---------------------------------|
| 1   | 01/16 | DA | DK   | AS BUILT                        |
| P2  | 10/30 | SG | DK   | REVISED BRIDGE SIZE             |
| P1  | 08/04 | DD | DK   | REVISED BRIDGE SIZE & U/S ELEV. |
| P0  | 08/03 | SG | DK   | ISSUED FOR REVIEW               |
| no. | date  | by | eng. | subject                         |


|                        |            |
|------------------------|------------|
| reproduction scale     |            |
| 0                      | 10 20 30   |
| plot date              | 2001/01/16 |
| scale                  | 1 : 1000   |
| drawn                  | DLD        |
| design                 | CIS        |
| checked                | DDK CIS    |
| map ref.               | 93 F/12    |
| revision               | sheet no.  |
| 1                      | 2 of 7     |
| drawing no.            |            |
| 00-C-211-2             |            |
| filename: 00C211-2.DWG |            |

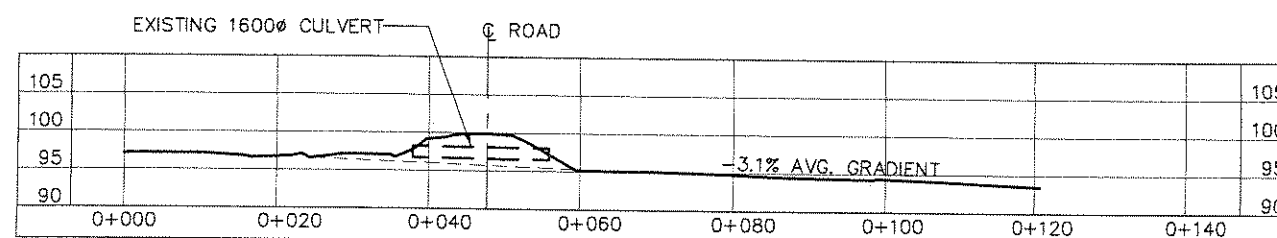


CREEK PROFILE

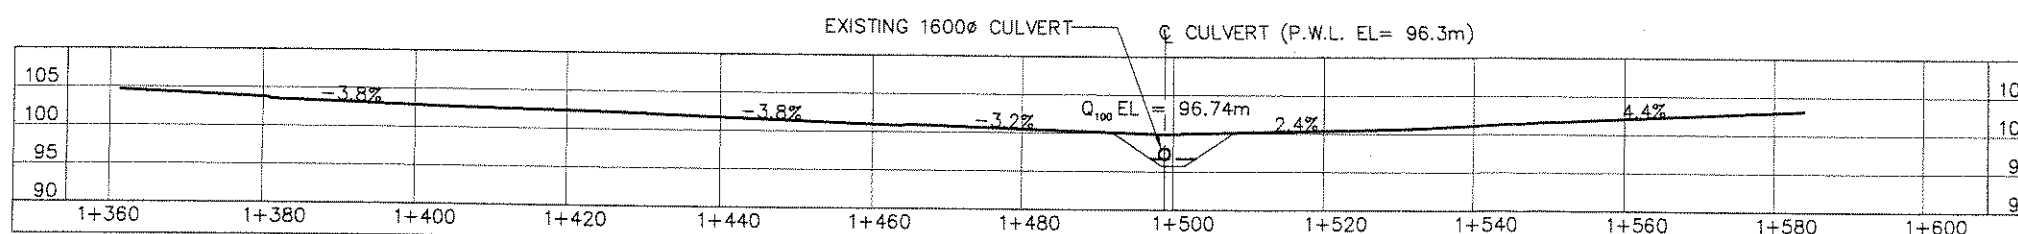

ROAD PROFILE

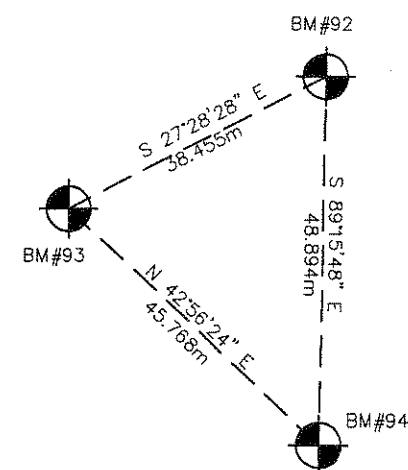


BENCHMARK LAYOUT

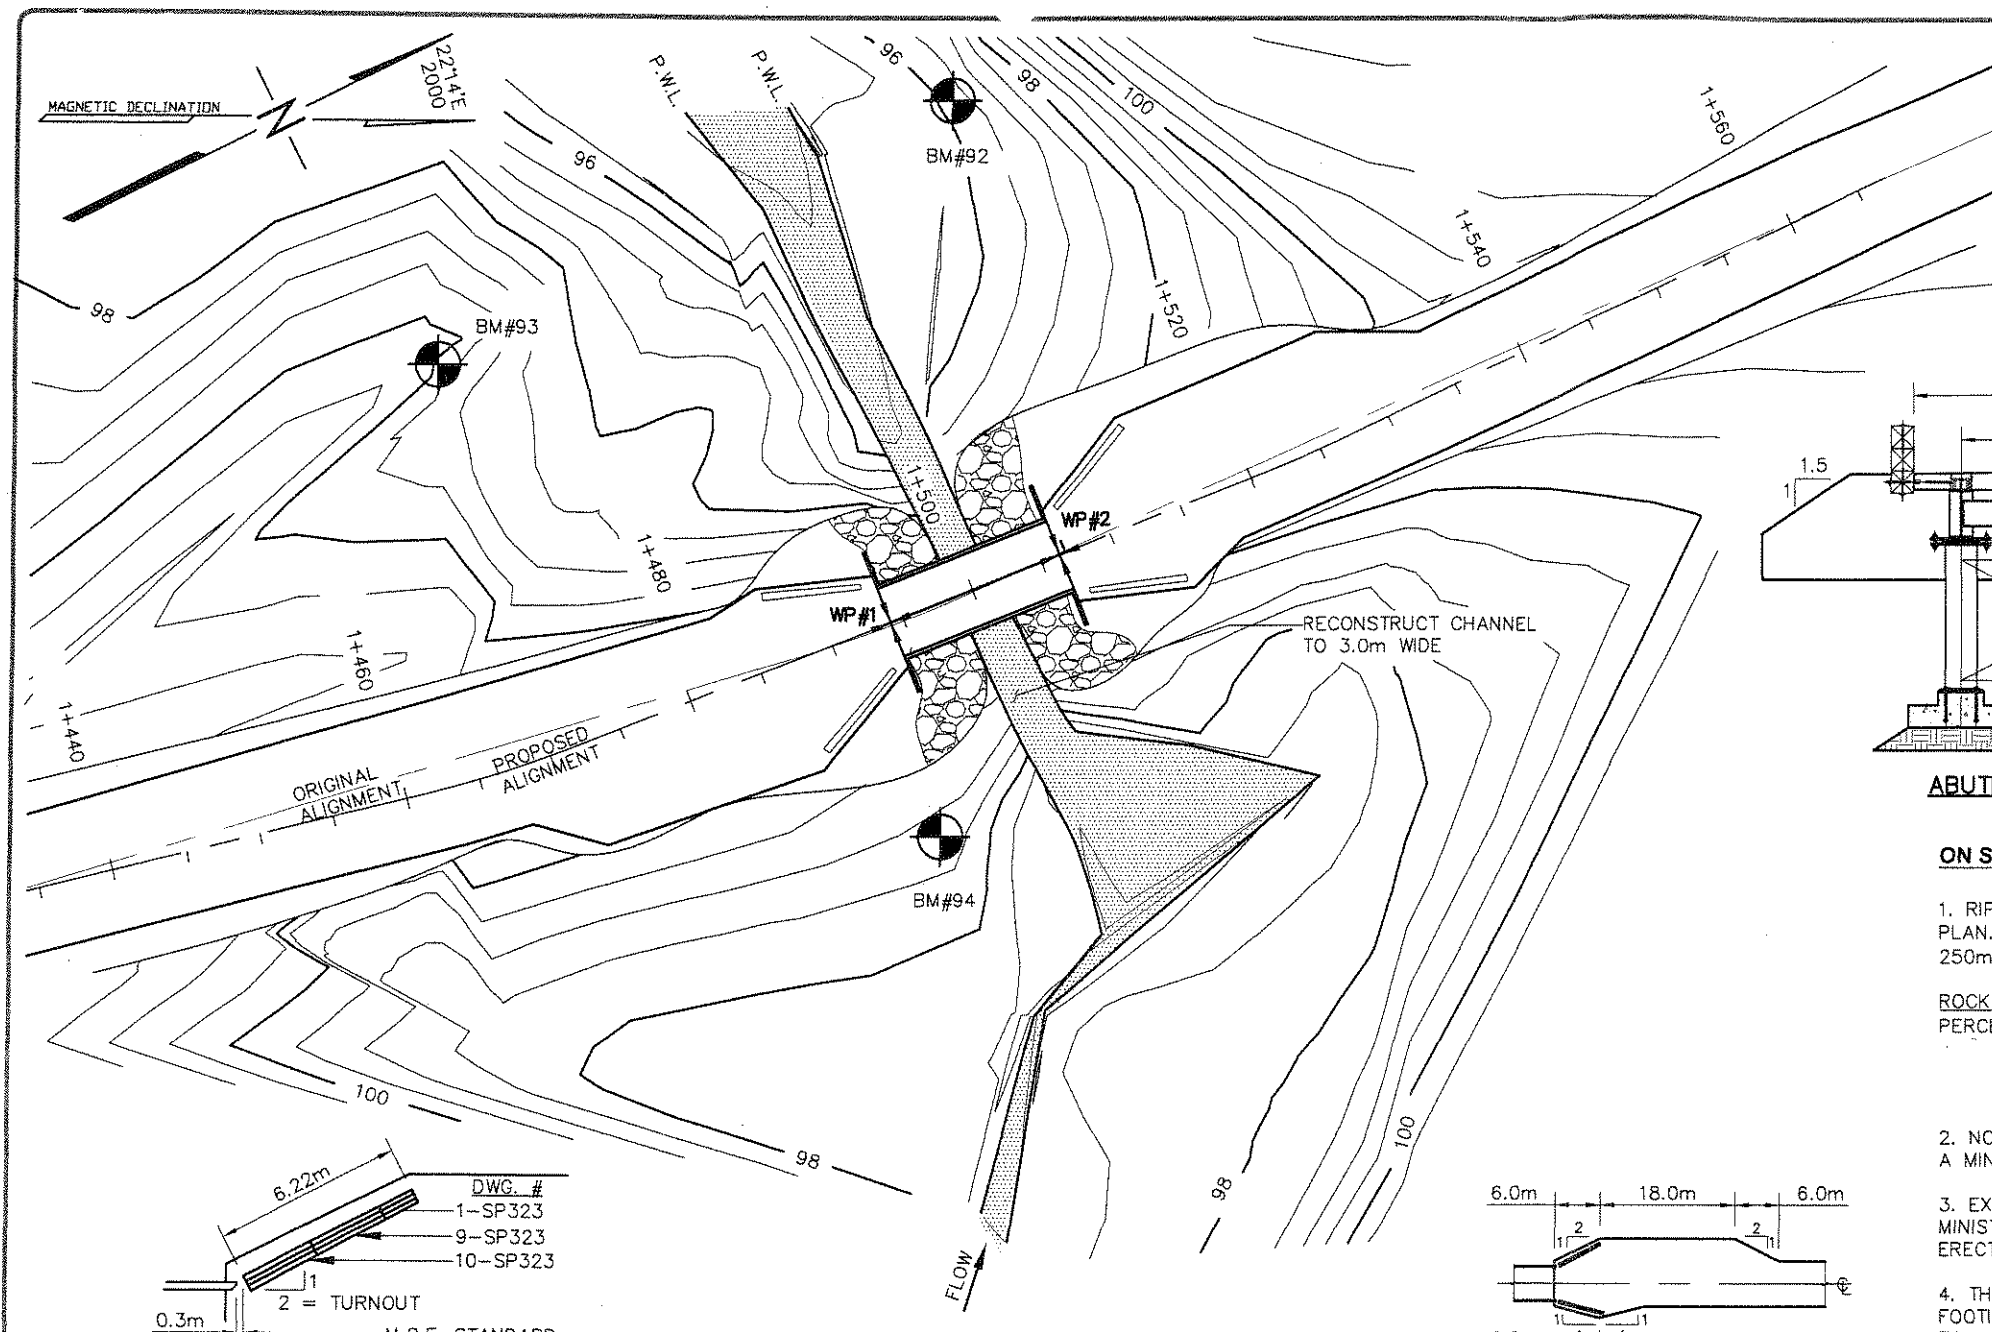

# **SURVEY INFORMATION:**

|       | ELEVATION | NORTHING | EASTING  |
|-------|-----------|----------|----------|
| BM#92 | 96.652    | 5009.604 | 4966.618 |
| BM#93 | 100.173   | 4975.470 | 4984.329 |
| BM#94 | 99.015    | 5008.976 | 5015.508 |
| WP#1  | 100.000   | 5001.262 | 5005.600 |
| WP#2  | 100.000   | 4996.705 | 5016.909 |

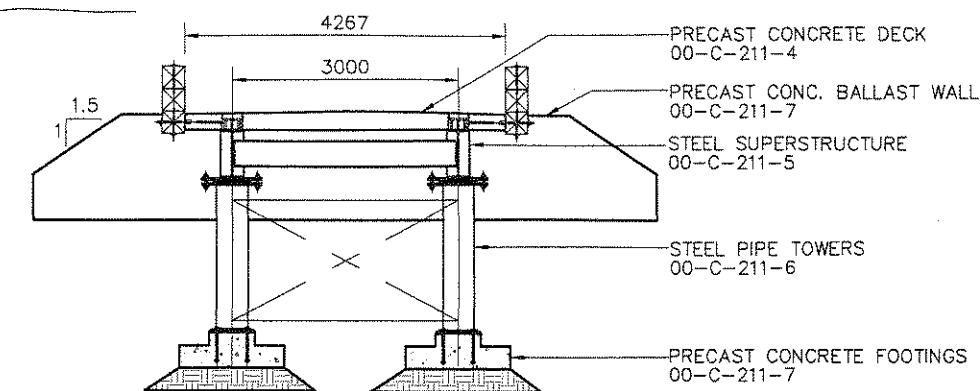

**ABUTMENT ELEVATION**  
SCALE 1:100

## **ON SITE SPECIFICATIONS:**

1. RIP-RAP SHALL EXTEND AROUND ABUTMENTS AS SHOWN ON THE PLAN. IT SHALL BE CLASS 100 AND HAVE A MINIMUM DEPTH OF 700mm, 250m<sup>3</sup> REQUIRED, CONSISTING OF THE FOLLOWING:

### **ROCK GRADATION:**

| PERCENTAGE LARGER THAN GIVEN ROCK MASS (kg) |       |       |
|---------------------------------------------|-------|-------|
| 85%                                         | 50%   | 15%   |
| 10kg                                        | 100kg | 300kg |
| 200ø                                        | 450ø  | 750ø  |

2. NON-WOVEN FILTER FABRIC TO BE PLACED OVER EXCAVATION TO HAVE A MINIMUM MULLEN BURST STRENGTH OF 2500kPa.


3. EXISTING STRUCTURE TO BE REMOVED AND DISPOSED OF MEETING MINISTRY APPROVAL. ALL DEBRIS SHALL BE REMOVED PRIOR TO ERECTION OF NEW STRUCTURE.

4. THE CONTRACTOR IS TO CONTACT THE ENGINEER PRIOR TO PLACING FOOTINGS. FOOTING PLACEMENT SHALL BE SUPERVISED BY THE ENGINEER TO CONFIRM BEARING REQUIREMENTS.


5. BACKFILL OF APPROACHES SHALL GENERALLY CONFORM TO THE LINES SHOWN ON THE DRAWINGS AND SHALL BE PLACED IN LIFTS NOT EXCEEDING 305mm THICK, COMPACTED TO 95% STANDARD PROCTOR DENSITY. MATERIAL SHALL BE CLEAN, FREE DRAINING, WELL GRADED GRANULAR FILL OF 75mm MAXIMUM SIZE. LIFTS SHALL ALTERNATE BOTH WAYS @ EACH END OF THE BRIDGE TO ENSURE MINIMAL MOVEMENT. USE LIGHT MECHANICAL TAMPERS ONLY.

## **LOADING DIAGRAM L-100 OFF HIGHWAY G.V.W. = 90 680kg:**


DESIGN IN ACCORDANCE WITH CAN3-S6-M88 WITH MODIFIED LOADING AS FOLLOWS:

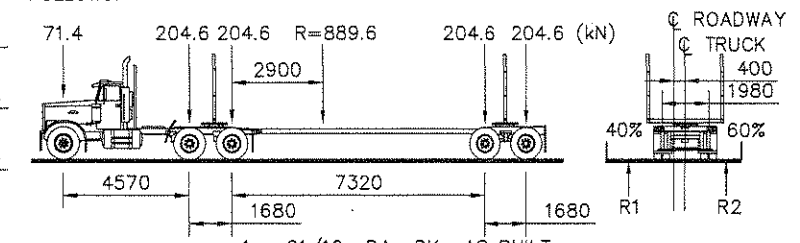


| 1   | 01/16 | DA | DK   | AS BUILT          |
|-----|-------|----|------|-------------------|
| P1  | 10/30 | SG | DK   | ISSUED FOR REVIEW |
| P0  | 08/28 | DD | DK   | ISSUED FOR REVIEW |
| no. | date  | by | eng. | subject           |

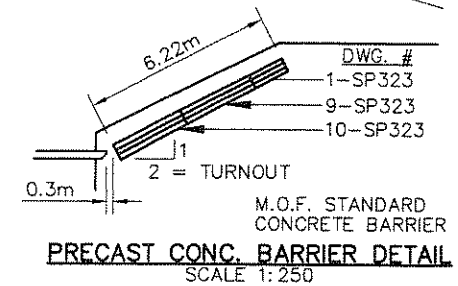


**PRECAST CONC. BARRIER DETAIL**  
SCALE 1:250

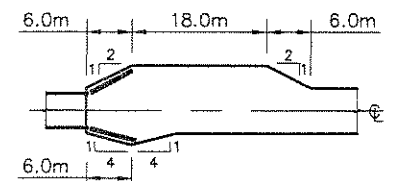

**TURNOUT DETAIL**  
SCALE 1:1000

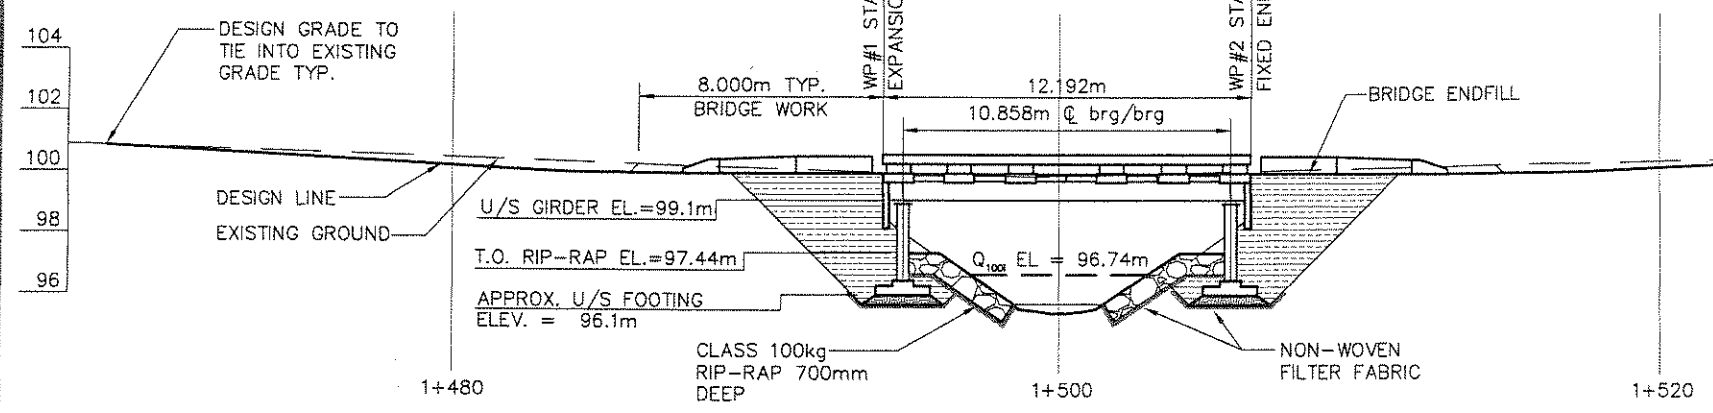

**BRIDGE PROFILE**  
SCALE 1:250

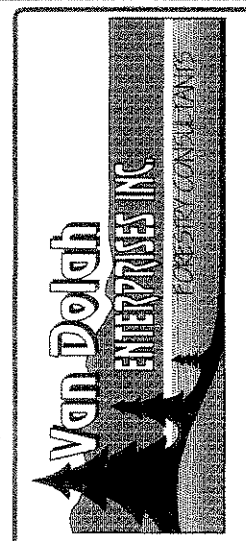


UNNAMED CREEK  
CHELASLIE M/L  
km 1+500  
AS BUILT

BRIDGE LAYOUT  
PLAN, PROFILE  
& ABUTMENT  
ELEVATION




301-1777 THIRD AVE.  
PRINCE GEORGE  
B.C. 562-7291

|                        |           |
|------------------------|-----------|
| reproduction scale     |           |
| 10                     | 20        |
| plot date: 2001/01/16  |           |
| scale: 1 : 500         |           |
| drawn: SAG             |           |
| design: CIS            |           |
| checked: DDK           |           |
| map ref: 93 F/12       |           |
| revision               | sheet no. |
| 1                      | 3 of 7    |
| drawing no.            |           |
| 00-C-211-3             |           |
| filename: 00C211-3.DWG |           |

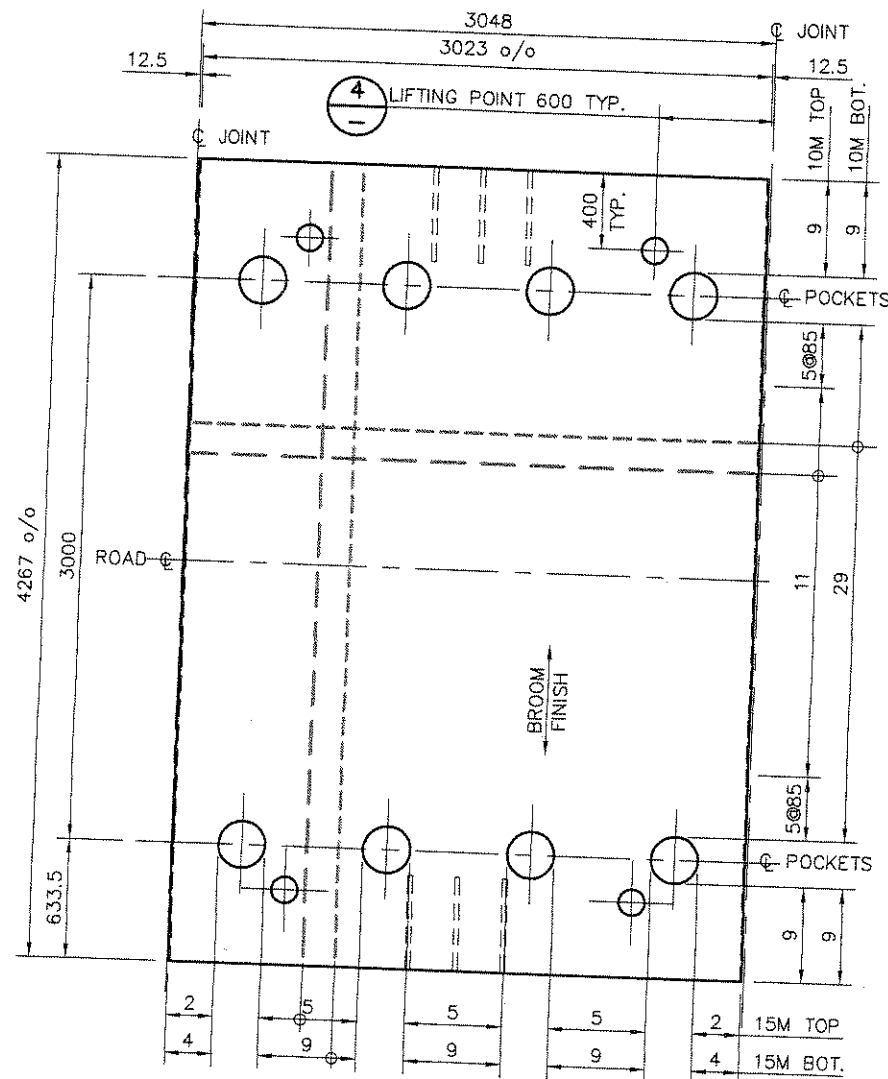


NOTE: REINFORCING TO BE EVENLY DISTRIBUTED BETWEEN SHEAR STUD POCKET LOCATIONS


PLAN - MKA

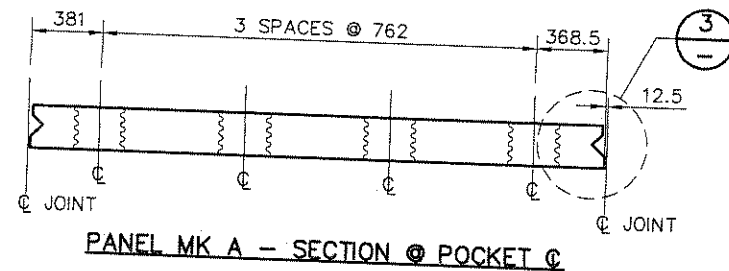


PANEL MK A - SECTION @ POCKET

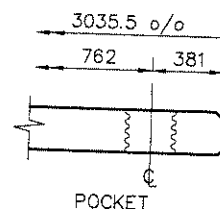


PANEL MK B - END DETAIL  
SAME AS MK A, EXCEPT THIS  
DETAIL ONE END ONLY.

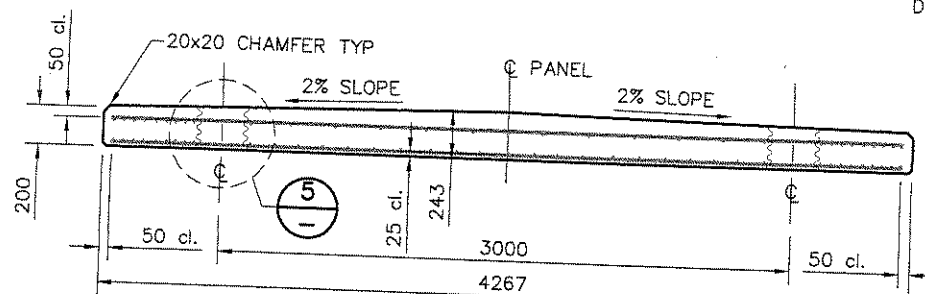


TYPICAL PANEL SECTION

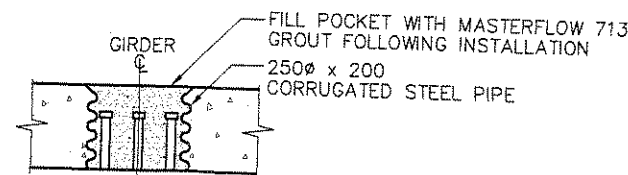


5 SHEAR POCKET DETAIL  
SCALE 1:20

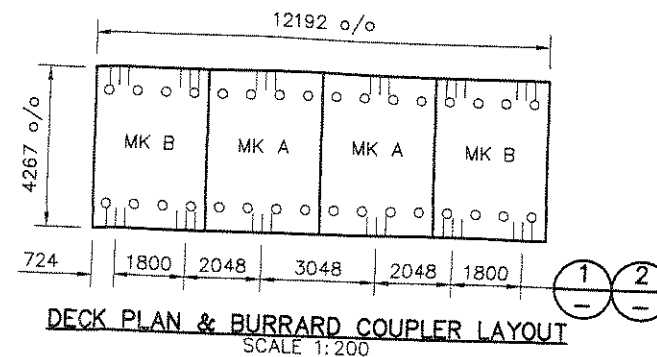


DECK PLAN & BURRARD COUPLER LAYOUT  
SCALE 1:200

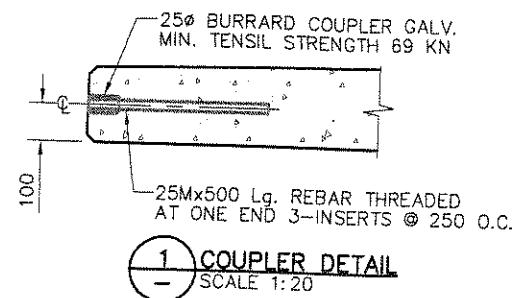


1 COUPLER DETAIL  
SCALE 1:20

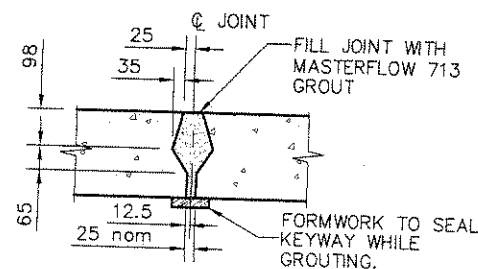

3 TYPICAL GROUT JOINT  
SCALE 1:20

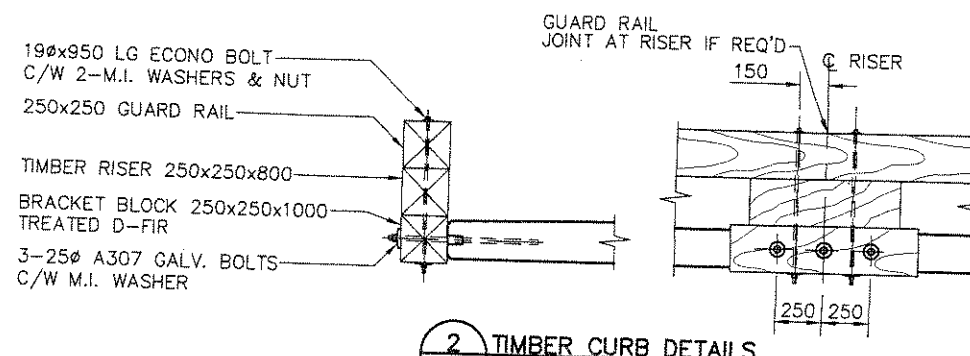

2 TIMBER CURB DETAILS

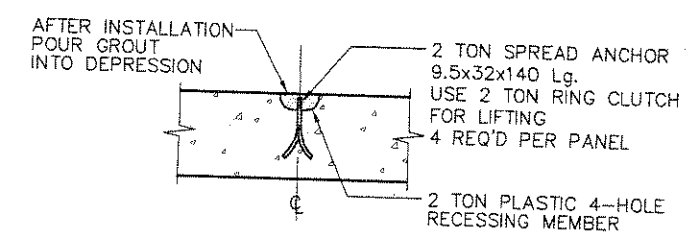

4 BURKE LIFTING INSERT


#### CONCRETE NOTES:

- CONCRETE FOR BALLAST WALL AND FOOTINGS SHALL CONFORM TO CSA CAN3-A23.1 AND CAN3-23.4-M78 WITH THE FOLLOWING SPECIFICATIONS:
  - 35MPa STRENGTH @ 28 DAYS
  - MAX. AGGREGATE 25mm
  - MIN. ENTRAINED AIR 5% ± 1%
  - MAX. SLUMP 30mm ± 20mm
  - FINISH - ROUGH TRANSVERSE BROOM FINISH
  - MAX. W/C RATIO BY MASS 0.38
  - DECK PANELS TO BE MADE IN A C.S.A. APPROVED SHOP.
- GROUT TO BE EXPANDING WITH A MINIMUM 50MPa 28 DAY STRENGTH & SHALL BE APPLIED ACCORDING TO MANUFACTURER'S INSTRUCTIONS.
- ALL REINFORCING STEEL TO BE DEFORMED BARS CONFORMING TO CSA G30.12-M, GRADE 400.
- CONCRETE TEST CERTIFICATES TO BE FORWARDED TO THE ENGINEER.

#### TIMBER NOTES:

- TIMBER RAILS AND RISERS SHALL BE UNTREATED S.P.F. CONSTRUCTION GRADE OR BETTER.
- RISER AND BRACKET TIMBERS SHALL BE D-FIR OR PINE #1 C.C.A. TREATMENT. MOUNT BRACKETS TO CONCRETE PANELS AT THE SHOP.

|     |       |    |      |                   |
|-----|-------|----|------|-------------------|
| 1   | 01/16 | DA | DW   | AS BUILT          |
| PO  | 10/30 | SG | DW   | ISSUED FOR REVIEW |
| no. | date  | by | eng. | subject           |

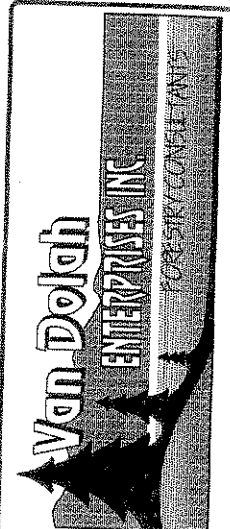









UNNAMED CREEK  
CHELASIE M/L  
km 1+500  
AS BUILT

PRECAST  
CONCRETE DECK  
PANEL DETAILS  
& LAYOUT



301-1777 THIRD AVE.  
PRINCE GEORGE  
B.C. 562-7291


|                    |              |           |        |
|--------------------|--------------|-----------|--------|
| reproduction scale | 10           | 20        | 30     |
| plot date          | 2001/01/16   |           |        |
| scale              | 1 : 40       |           |        |
| drawn              | SAG          |           |        |
| design             | DDW          |           |        |
| checked            | DDK          | DDW       |        |
| map ref.           |              |           |        |
| revision           | 1            | sheet no. | 4 of 7 |
| drawing no.        | 00-C-211-4   |           |        |
| filename:          | 00C211-4.DWG |           |        |

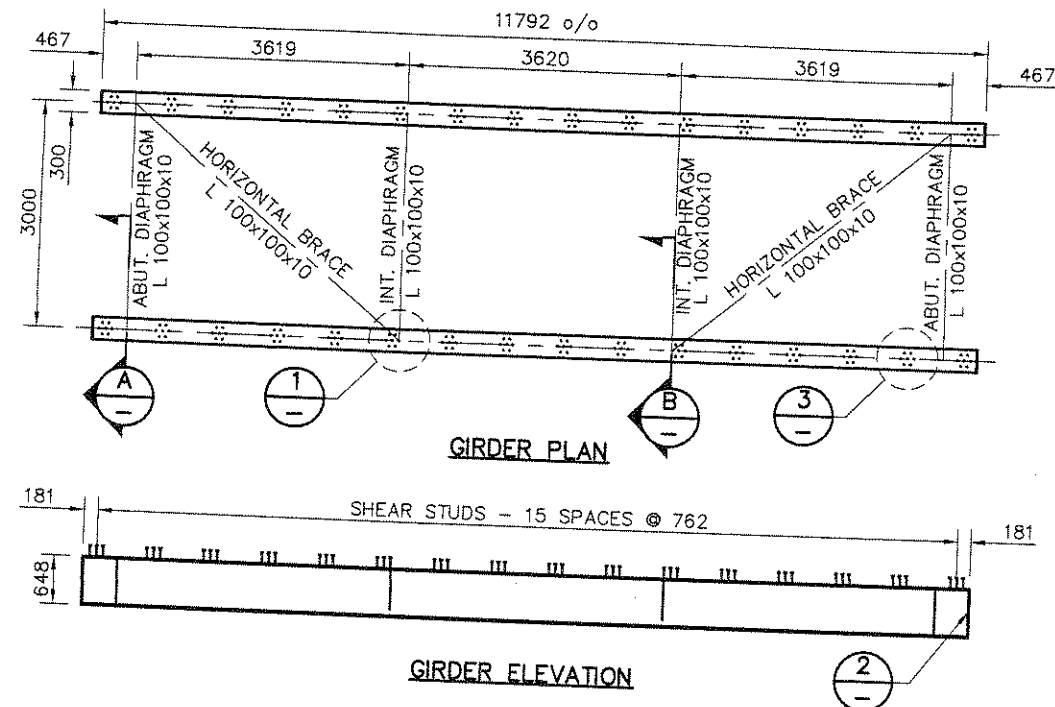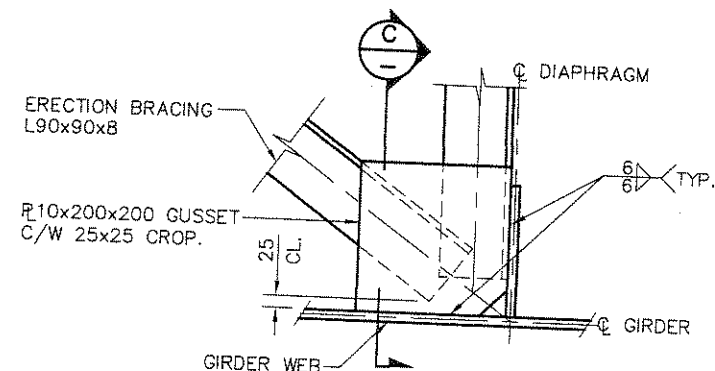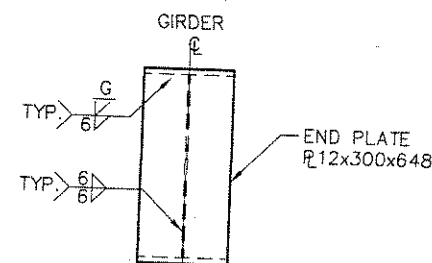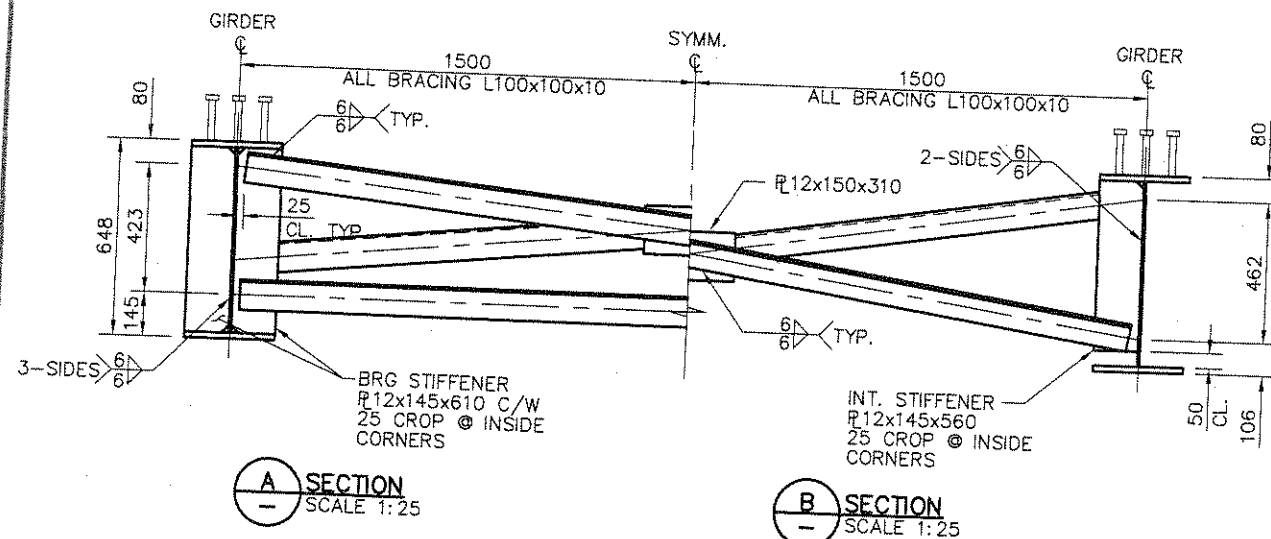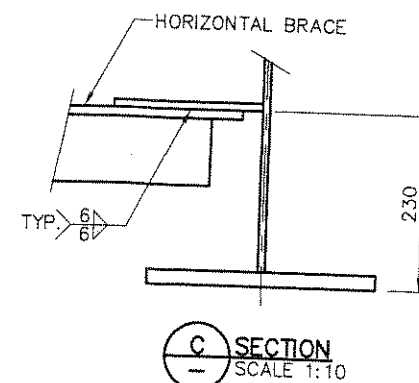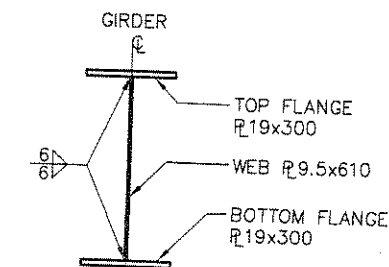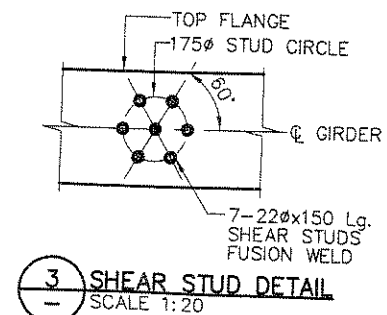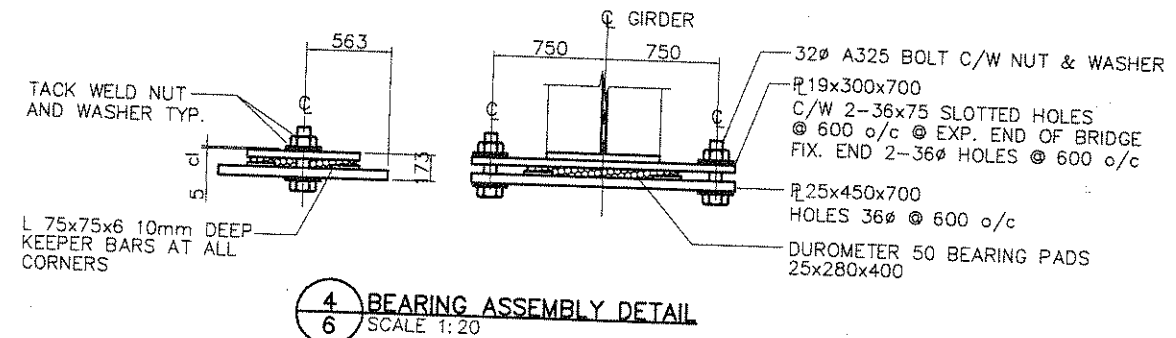

#### STEEL NOTES:

- STRUCTURAL STEEL SHALL BE IN ACCORDANCE WITH CSA STANDARD G40.21-M81, GRADE 350AT, CATEGORY 3. MILL CERTIFICATES TO BE FORWARDED TO THE ENGINEER.
- ALL OTHER STEEL (INCLUDING ANGLES) SHALL COMPLY TO GRADE 350A.
- GIRDERS ARE DESIGNED AS FRACTURE CRITICAL MEMBERS.
- CHARPY V-NOTCH TESTS SHALL BE SPECIFIED ON A PER-HEAT FREQUENCY.
- WELDING SHALL BE IN ACCORDANCE WITH CSA STANDARD W-59. WELDING ELECTRODES TO BE COMPATIBLE WITH BASE METAL. ALL WELDS TO BE 6mm UNLESS OTHERWISE NOTED ON DRAWINGS.
- ALL BOLTS TO BE ASTM A325.
- ALL BEARING PADS TO BE NATURAL RUBBER WITH DUROMETER HARDNESS OF 50 (GRADE 5).
- CONTACT ENGINEER FOR FABRICATION INSPECTIONS, A MINIMUM 2 WEEKS PRIOR TO SHIPPING.

|     |       |    |      |                   |
|-----|-------|----|------|-------------------|
| 1   | 01/16 | DA | DW   | AS BUILT          |
| PO  | 10/30 | SG | DW   | ISSUED FOR REVIEW |
| no. | date  | by | eng. | subject           |

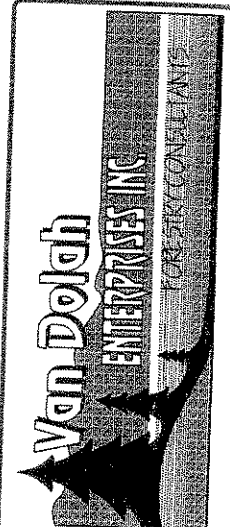

UNNAMED CREEK  
CHELASLIE M/L  
km 1+500  
AS BUILT


STEEL  
SUPERSTRUCTURE  
PLAN, ELEVATION  
& DETAILS




ALLNORTH  
CONSULTANTS  
LIMITED

301-1777 THIRD AVE.  
PRINCE GEORGE  
B.C. V6B 2Y2


|                    |              |           |        |
|--------------------|--------------|-----------|--------|
| reproduction scale | 10           | 20        | 30     |
| plot date          | 2001/01/16   |           |        |
| scale              | 1 : 100      |           |        |
| drawn              | SAG          |           |        |
| design             | DDW          |           |        |
| checked            | DDK          |           |        |
| map ref.           |              |           |        |
| revision           | 1            | sheet no. | 5 of 7 |
| drawing no.        | 00-C-211-5   |           |        |
| filename:          | DDC211-5.DWG |           |        |

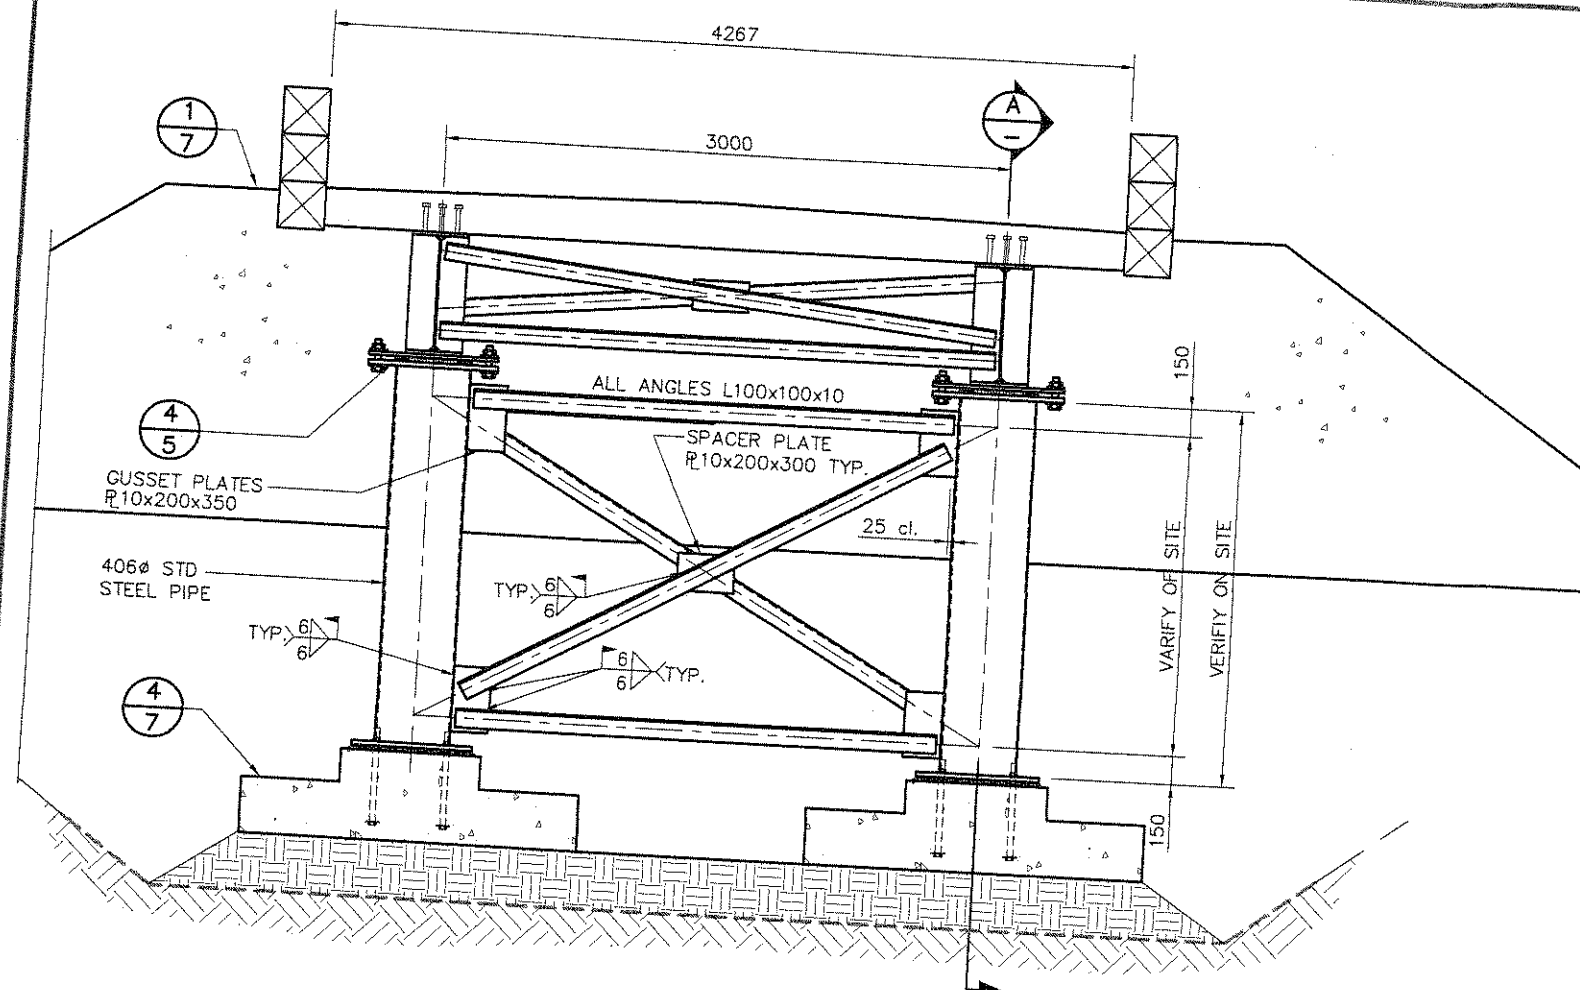

**TYPICAL ABUTMENT ELEVATION**  
SCALE 1:50

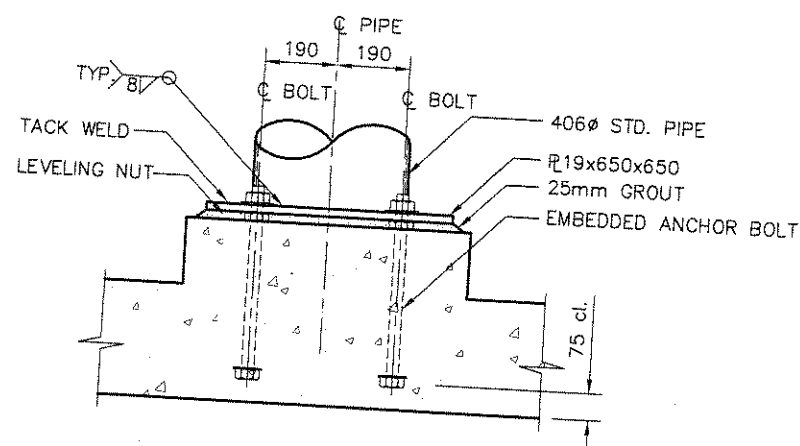

**1 DETAIL - TOWER CONNECTION**  
SCALE 1:20

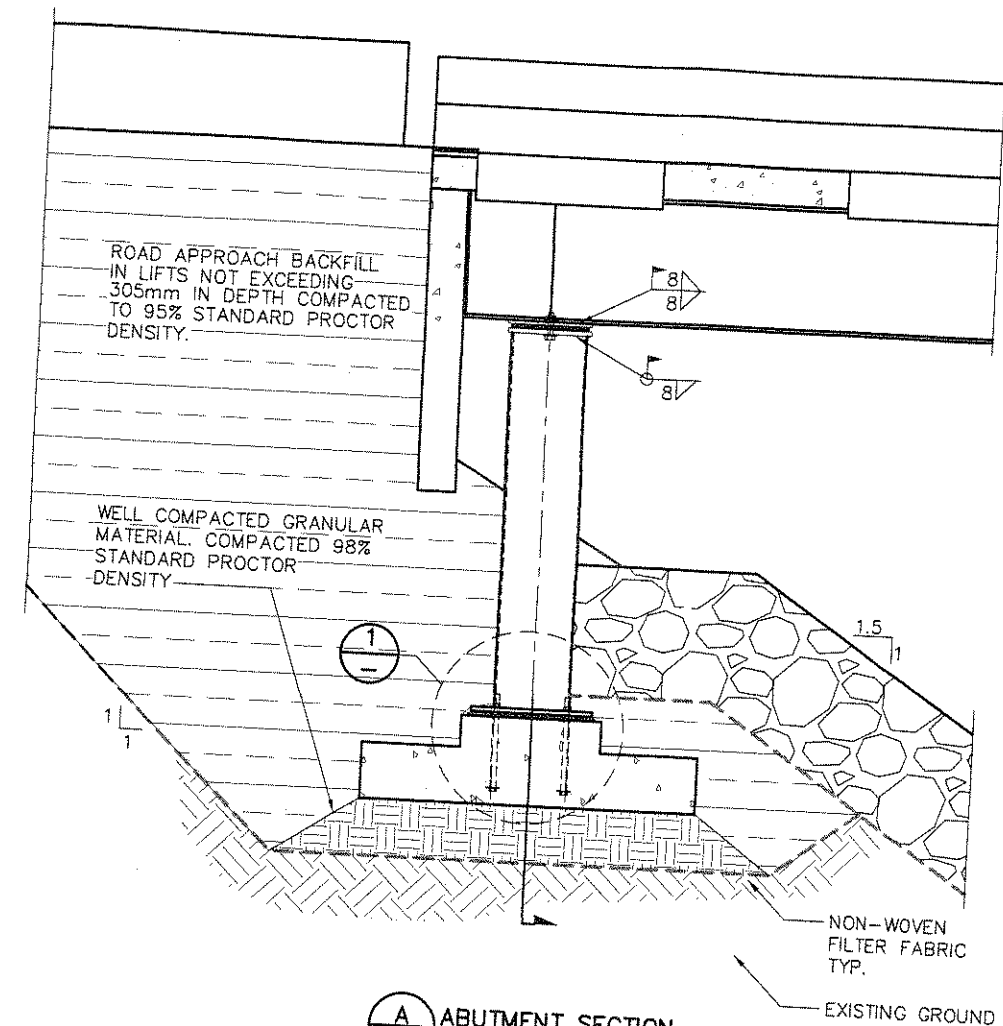


**A ABUTMENT SECTION**

**ABUTMENT NOTES:**

1. WELDING SHALL BE IN ACCORDANCE WITH CSA STANDARD W-59. WELDING ELECTRODES TO BE COMPATIBLE WITH BASE METAL. ALL WELDS TO BE 6mm UNLESS OTHERWISE NOTED ON DRAWINGS.
2. PIPE SHALL BE IN ACCORDANCE WITH ASTM SPECIFICATION A252 GRADE 2.
3. FOOTINGS HAVE BEEN DESIGNED FOR 200kPa MAXIMUM ALLOWABLE BEARING PRESSURE. A MINIMUM THICKNESS OF 300mm OF GRANULAR MATERIAL SHALL BE COMPACTED TO 98% STANDARD PROCTOR DENSITY BELOW EACH FOOTING. UNDER THE DIRECT SUPERVISION OF THE ENGINEER.
4. BACKFILL OF APPROACHES SHALL GENERALLY CONFORM WITH LINES ON DRAWINGS AND SHALL BE PLACED IN HORIZONTAL LIFTS NOT EXCEEDING 305mm THICK. COMPACT TO 95% STANDARD PROCTOR DENSITY. MATERIAL SHALL BE CLEAN, FREE DRAINING, WELL GRADED GRANULAR FILL OF 75mm MAXIMUM SIZE. USE LIGHT MECHANICAL TAMPERS ONLY. LIFTS SHALL ALTERNATE FROM EACH END OF BRIDGE TO ENSURE MINIMAL MOVEMENT.
5. GROUT TO BE EXPANDING WITH A MINIMUM 50MPa STRENGTH & SHALL BE APPLIED ACCORDING TO MANUFACTURERS INSTRUCTIONS.

| 1   | 01/16 | DA | DW   | AS BUILT          |
|-----|-------|----|------|-------------------|
| PO  | 10/30 | SG | DW   | ISSUED FOR REVIEW |
| no. | date  | by | eng. | subject           |

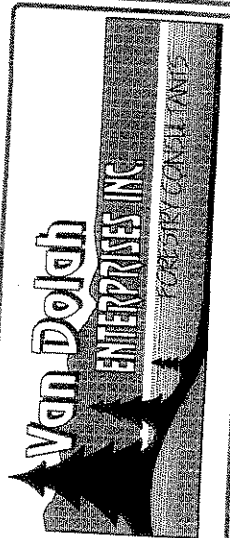







UNNAMED CREEK  
CHELASLIE M/L  
km 1+500  
AS BUILT

ABUTMENT  
ELEVATION  
SECTION  
& DETAILS



301-1777 THIRD AVE.  
PRINCE GEORGE  
B.C. V6L 2R1

|                    |              |
|--------------------|--------------|
| reproduction scale | 0 10 20 30   |
| plot date          | 2001/01/16   |
| scale              | 1:40         |
| drawn              | SAG          |
| design             | DDW          |
| checked            | DDK          |
| map ref.           | DDW          |
| revision           | sheet no.    |
| 1                  | 6 of 7       |
| drawing no.        | 00-C-211-6   |
| filename:          | 00C211-6.DWG |

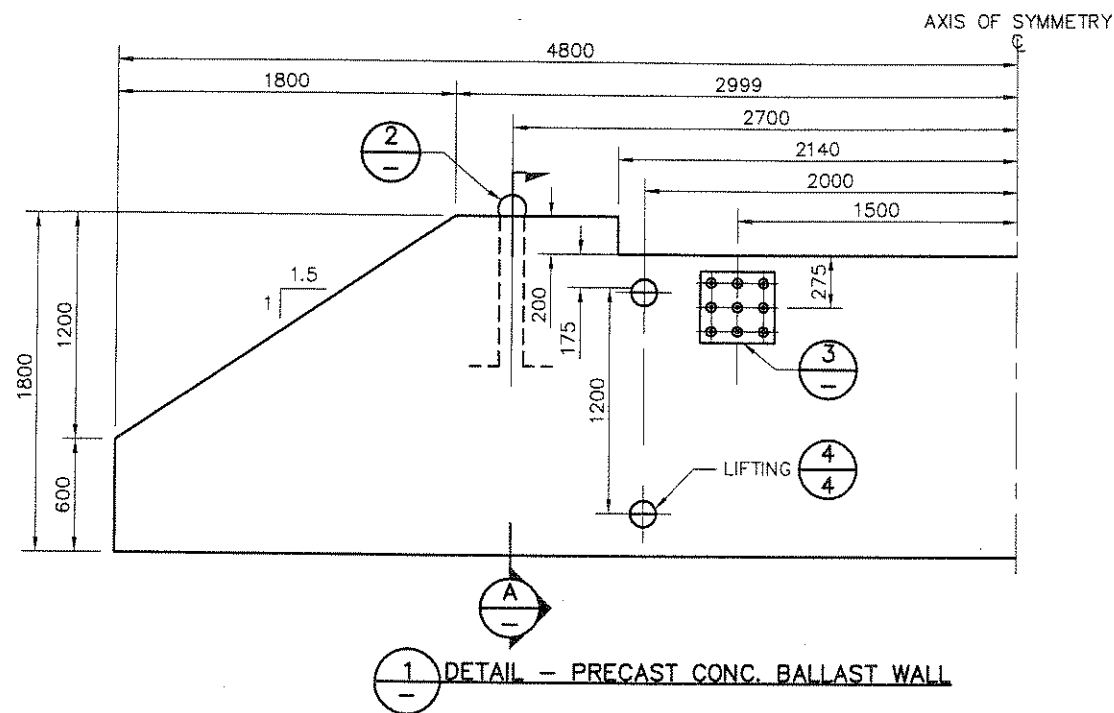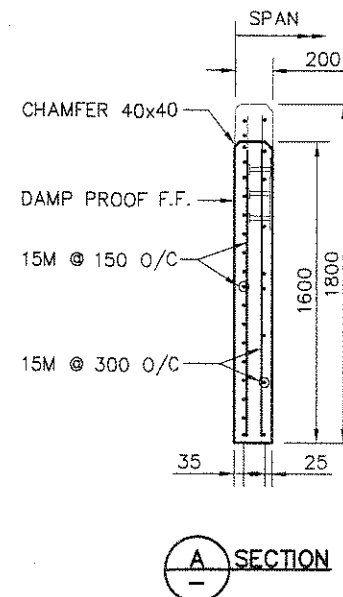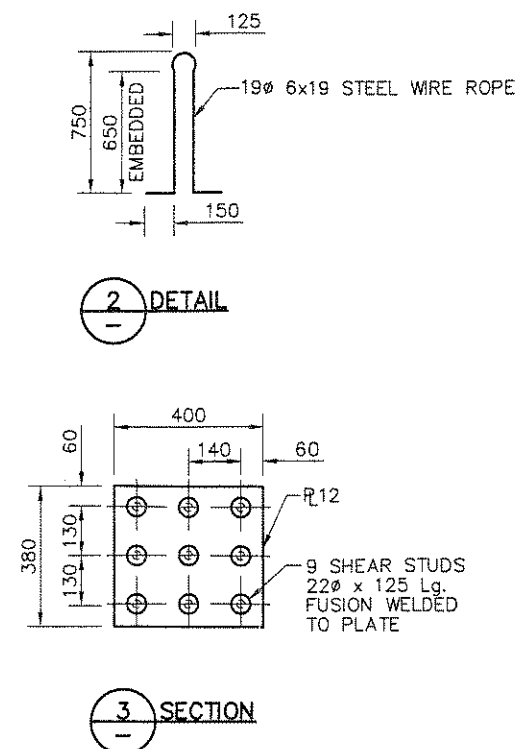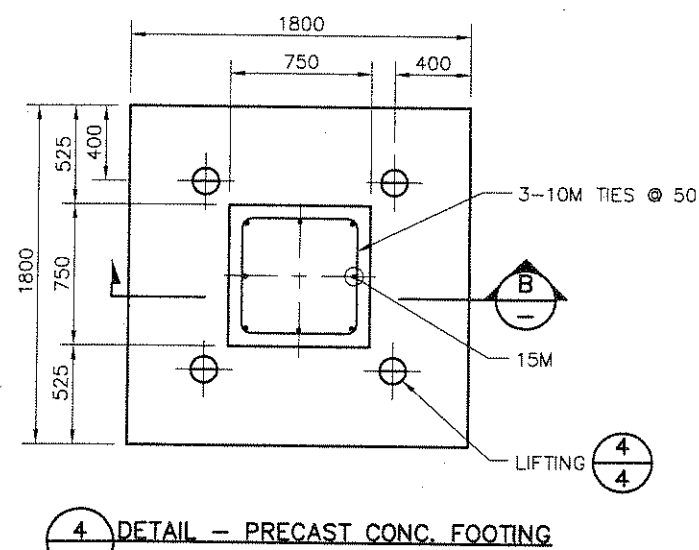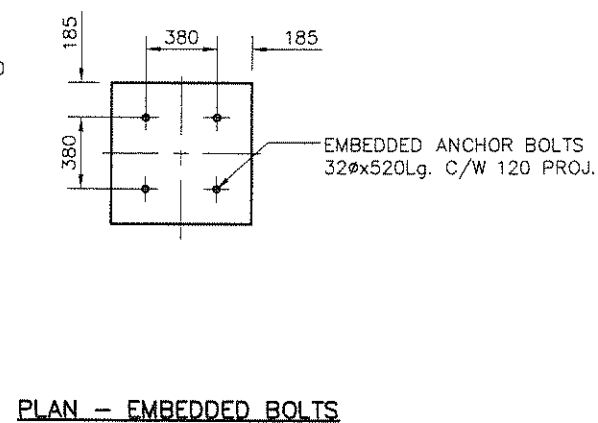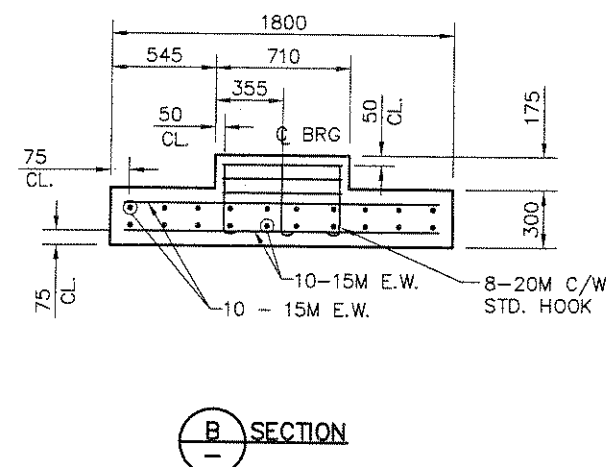

#### PRECAST CONCRETE NOTES:

- CONCRETE SHALL CONFORM TO CSA CAN3-A23.1 AND CAN3-23.4-M78 WITH THE FOLLOWING SPECIFICATIONS
  - 35MPa STRENGTH AT 28 DAYS
  - MAX. AGGREGATE 25mm
  - MIN. ENTRAINED AIR 6% ± 1%
  - MAX. SLUMP 30mm
  - REINFORCING TO CSA G30.21M, GRADE 400 MPa, ALL BARS CONT. LENGTH.
  - GROUT MASTERFLOW 713.
- WELDING SHALL BE IN ACCORDANCE WITH CSA STANDARD W-59
- BALLAST WALLS TO BE DAMP PROOFED ON REAR FACE WITH BLACK FOUNDATION IN SHOP.
- CONCRETE TEST CERTIFICATES TO BE FORWARDED TO THE ENGINEER.
- FOOTINGS HAVE BEEN DESIGNED FOR 200kPa MAXIMUM ALLOWABLE BEARING PRESSURE.

|     |       |    |      |                   |
|-----|-------|----|------|-------------------|
| 1   | 01/16 | DA | DW   | AS BUILT          |
| 0   | 10/30 | SG | DW   | ISSUED FOR REVIEW |
| no. | date  | by | eng. | subject           |

UNNAMED CREEK  
CHELASLIE M/L  
km 1+500  
AS BUILT

PRECAST CONC.  
BALLAST WALL  
& FOOTINGS

**ALLNORTH  
CONSULTANTS  
LIMITED**

301-1777 THIRD AVE.  
PRINCE GEORGE  
B.C. 562-7291

|                    |              |
|--------------------|--------------|
| reproduction scale |              |
| 0                  | 10 20 30     |
| plot date          | 2001/01/16   |
| scale              | 1:40         |
| drawn              | SAG          |
| design             | DDW          |
| checked            | DDK DDW      |
| map ref.           |              |
| revision           | sheet no.    |
| 1                  | 7 of 7       |
| drawing no.        | 00-C-211-7   |
| filename:          | 00C211-7.DWG |