


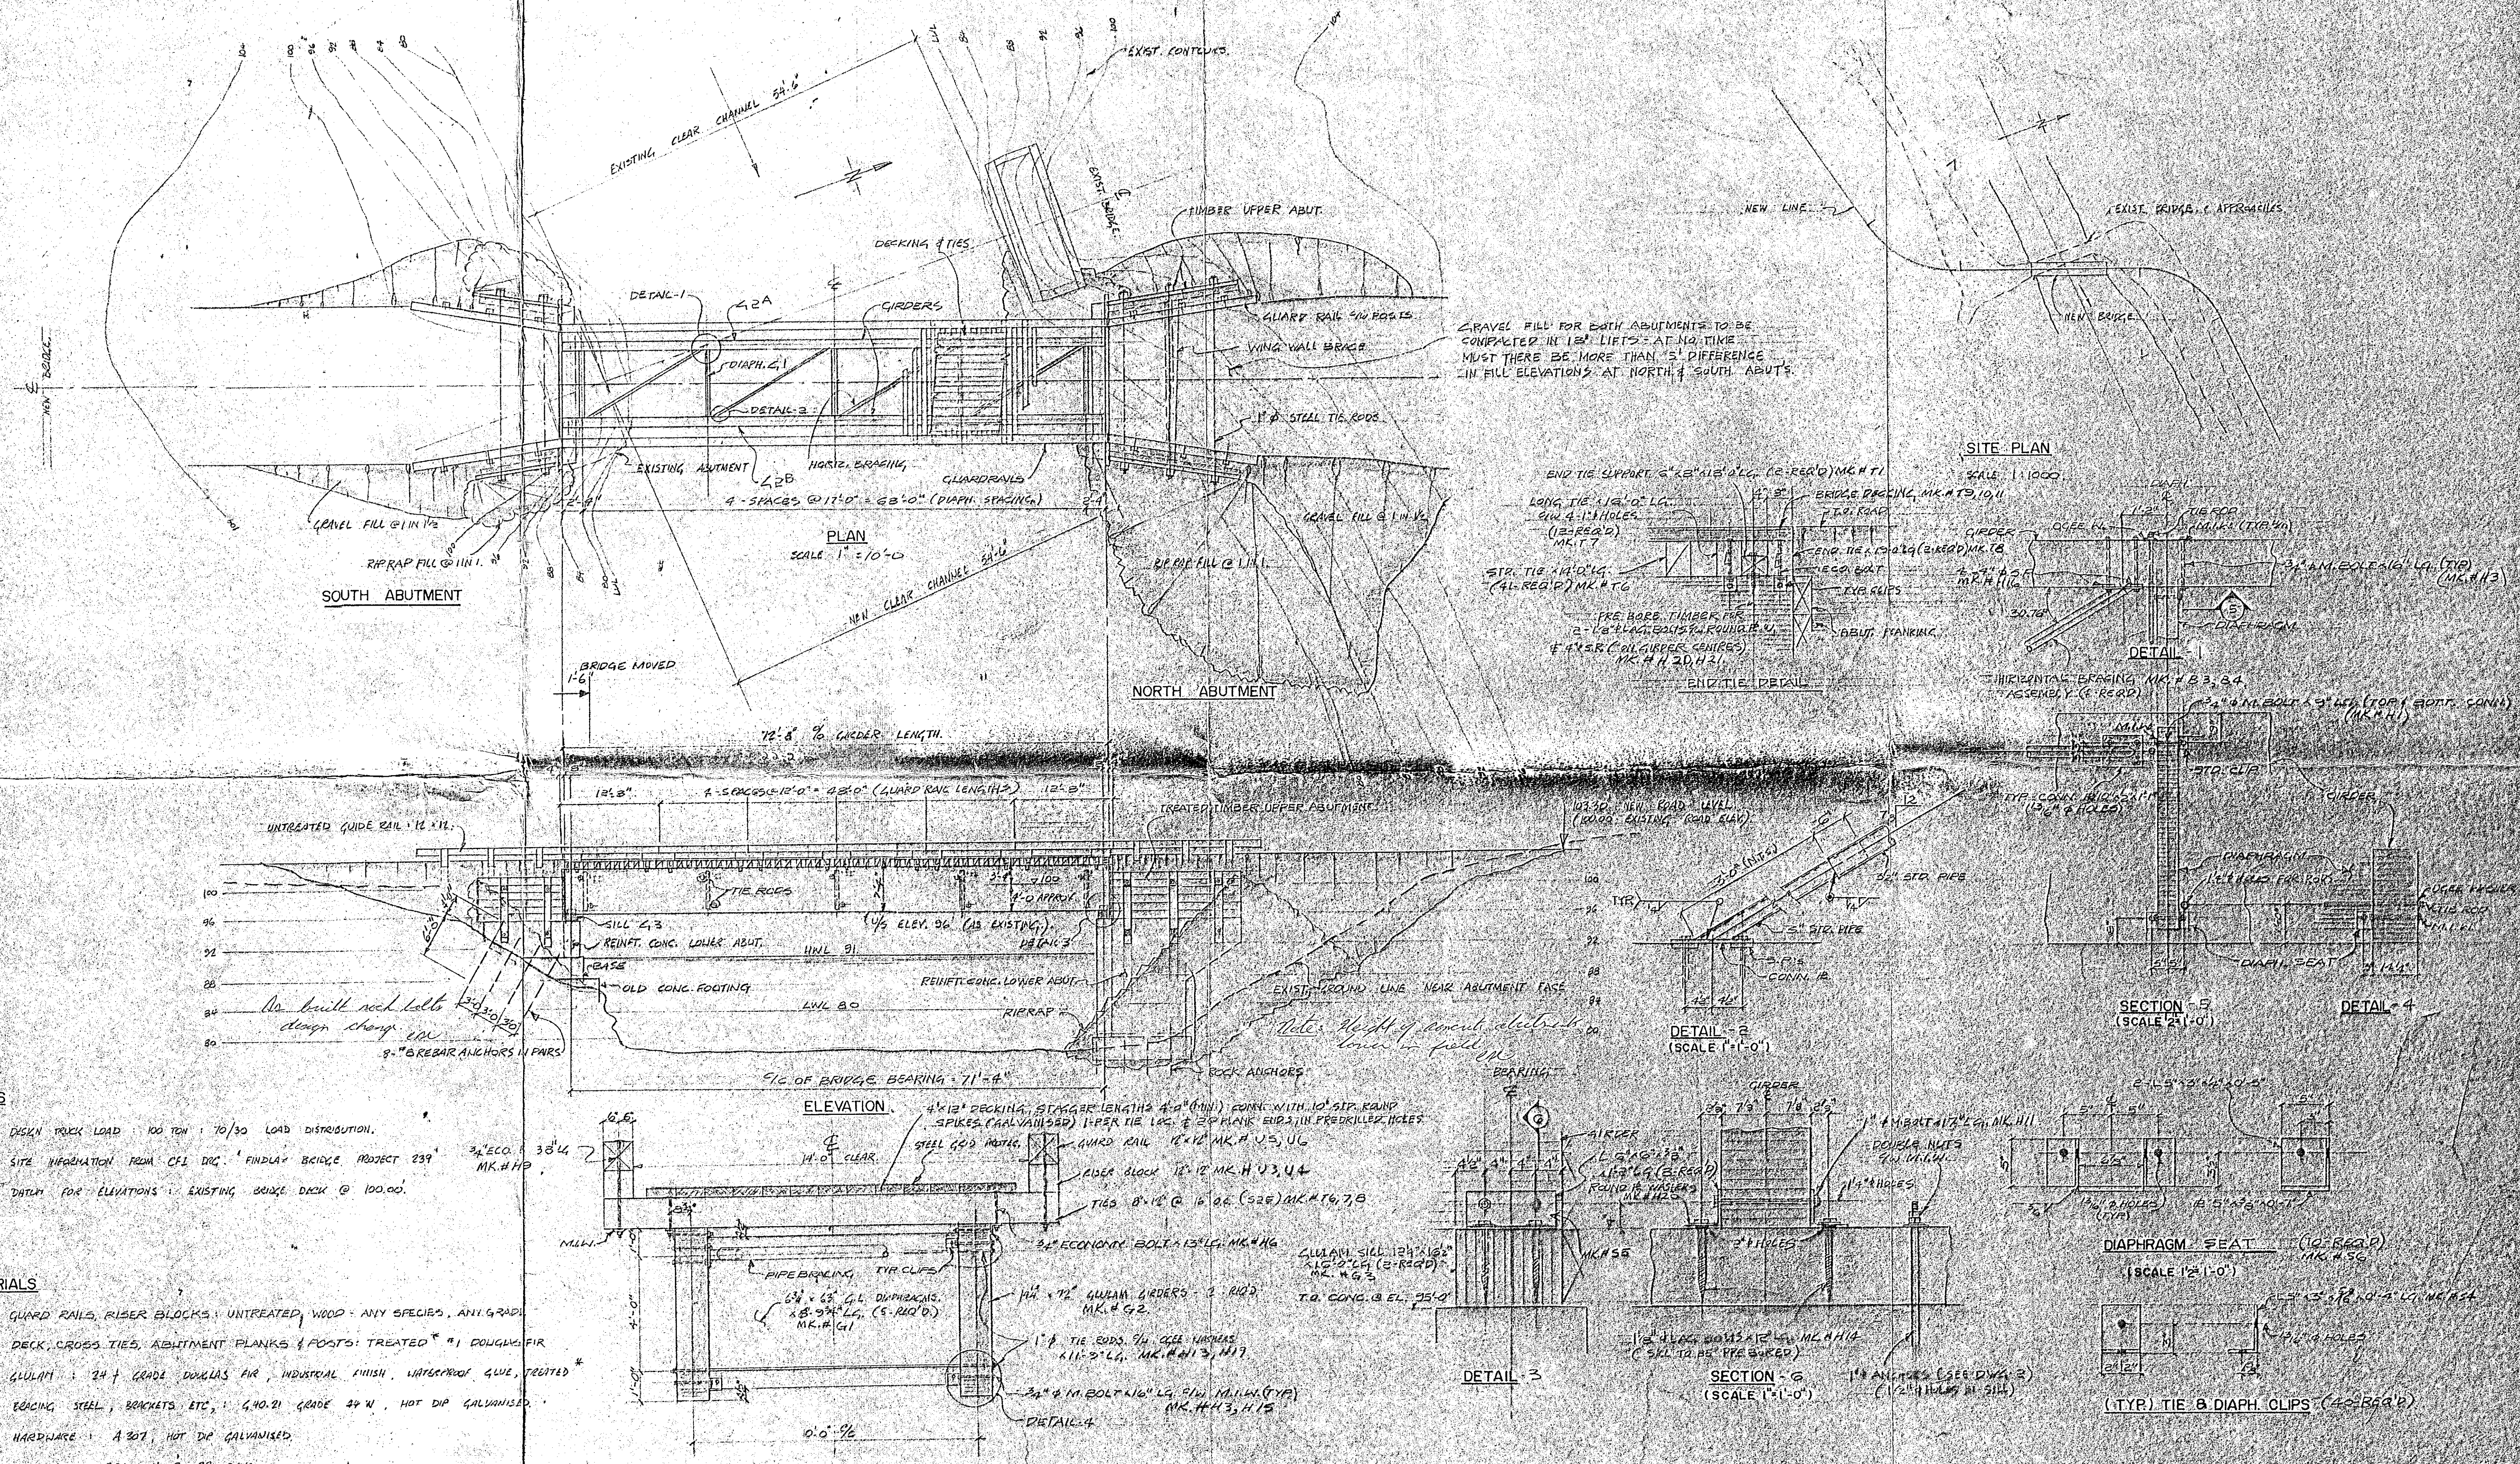

NOTES


- DESIGN TRUCK LOAD: 100 TON: 70/30 LOAD DISTRIBUTION.
- SITE INFORMATION FROM CFI DRC: FINDLAY BRIDGE PROJECT 239
- DATUM FOR ELEVATIONS: EXISTING BRIDGE DRAW @ 100.00.

MATERIALS

- GUARD RAILS, RISER BLOCKS: UNTREATED WOOD: ANY SPECIES, ANY GRADE
- DECK, CROSS TIES, ABUTMENT PLANKS & POSTS: TREATED #1 DOUGLAS FIR
- GLULAM: 24' GRADE DOUGLAS FIR, INDUSTRIAL FINISH, WATERPROOF GLUE, TREATED*
- BRACING STEEL, BRACKETS, ETC.: 40-21 GRADE 40 W, HOT DIP GALVANIZED
- HARDWARE: A307 HOT DIP GALVANIZED
- CONCRETE: 3000 PSI @ 28 DAYS
- REINFORCING BARS: INTERMEDIATE GRADE DEFORMED BARS

CROSS SECTION - GLULAM
PAGE 76 OF 111

REVISION	DATE	BY	CHKD	APP'D
1	2/25/82	DRWN AS BUILT		
2	3/1/82	DETAILS ADDED		
3	3/1/82	REBRIDGE		

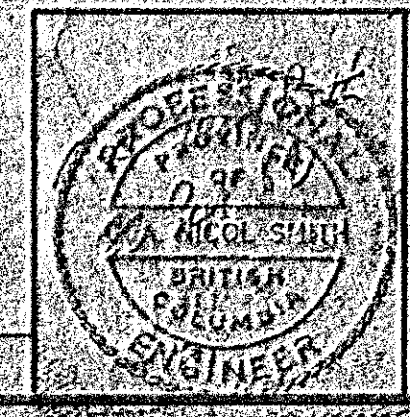

GOWER, YEUNG & ASSOCIATES LTD.
CONSULTING ENGINEERS
380, 522-7th STREET
NEW WESTMINSTER, B.C. V2M 4G2

CRESTBROOK FOREST INDUSTRIES			
FINDLAY 15KM BRIDGE	DRAWN: 32	DATE: MARCH 1982	
GENERAL ARRANGEMENT	CHECKED: 1218	DATE: March 2/82	
	PROJ. NO. 1218	DWG. NO. 1 of 2	

SEP 24 1982