




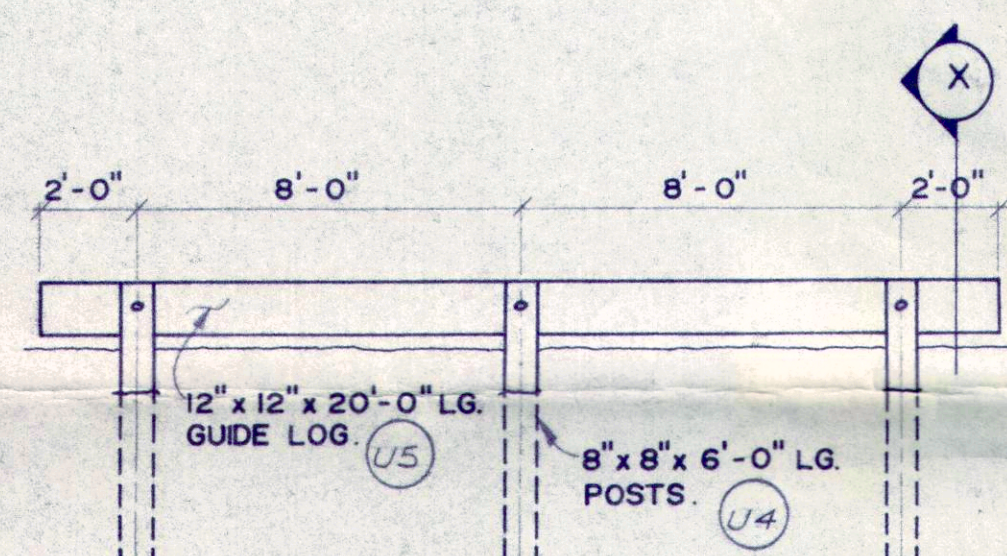


GUIDE RAIL DETAIL
SCALE 1/4"=1'-0"

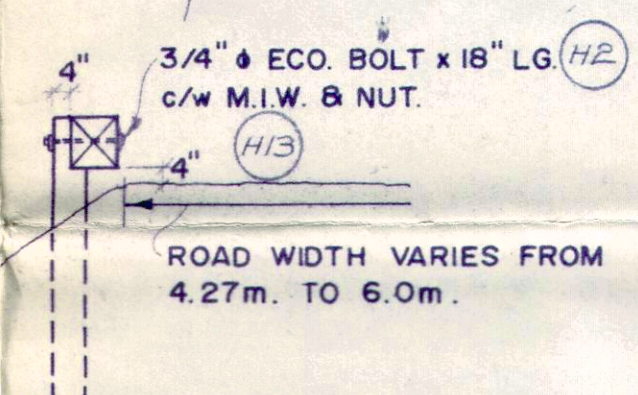

SECTION X

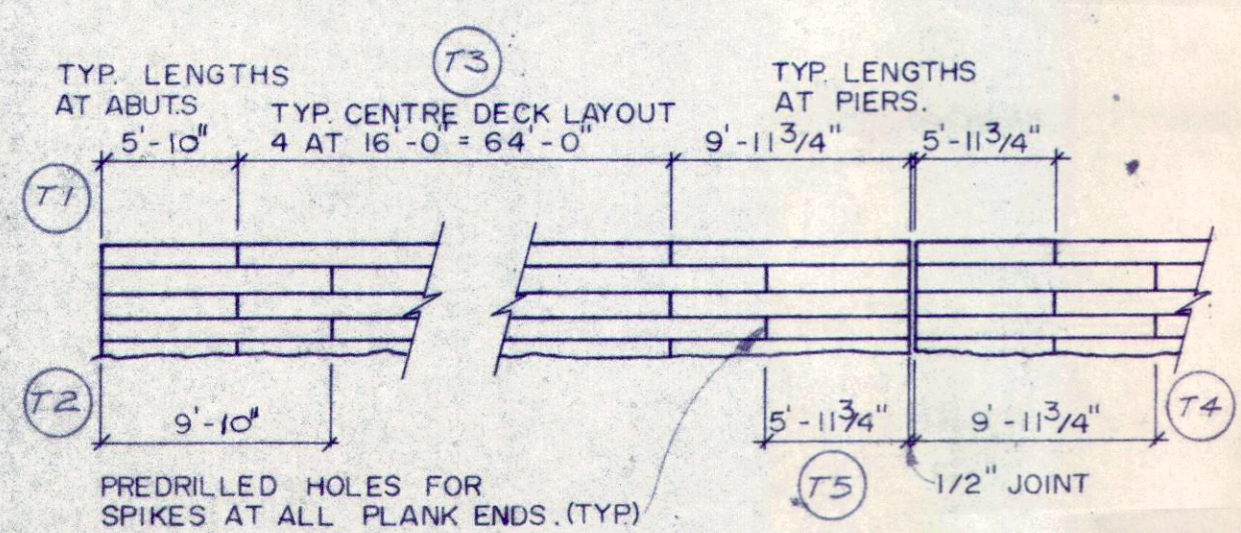


BRIDGE DECK LAYOUT
SCALE 1/8"=1'-0"

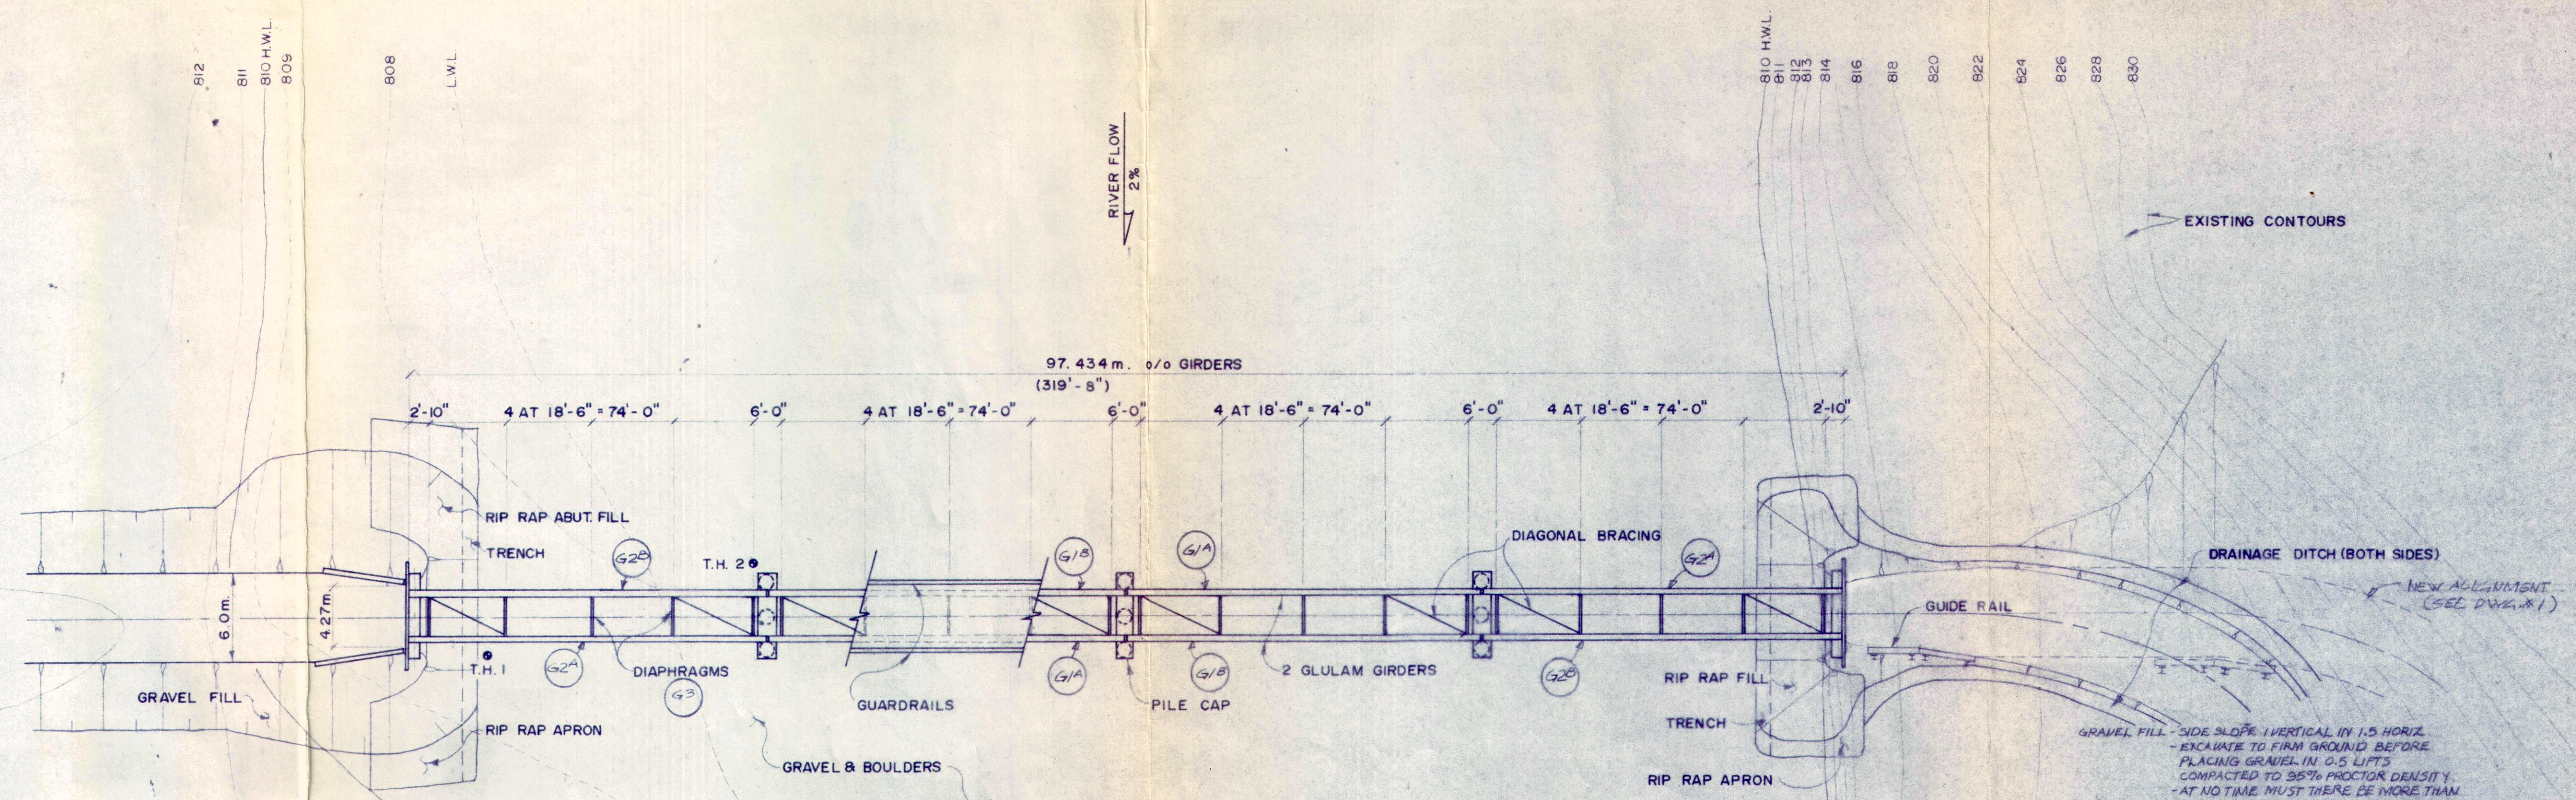


PLAN
SCALE 1:250


NOTE: ABUTMENT ENDS ON ALL 42 GIRDERS ARE MARKED "END"
CENTRE PIER (3) ENDS ON ALL 41 GIRDERS ARE MARKED "CP"

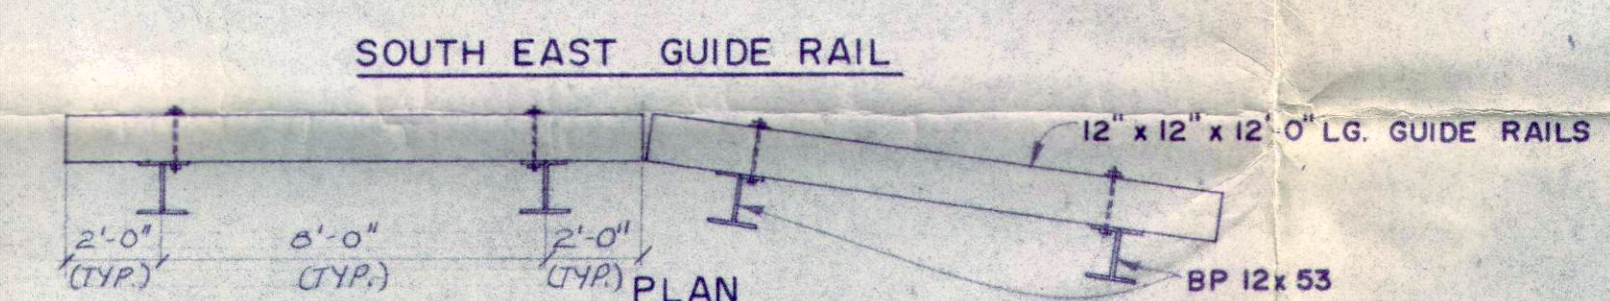

PLAN
SCALE 1/4"=1'-0"

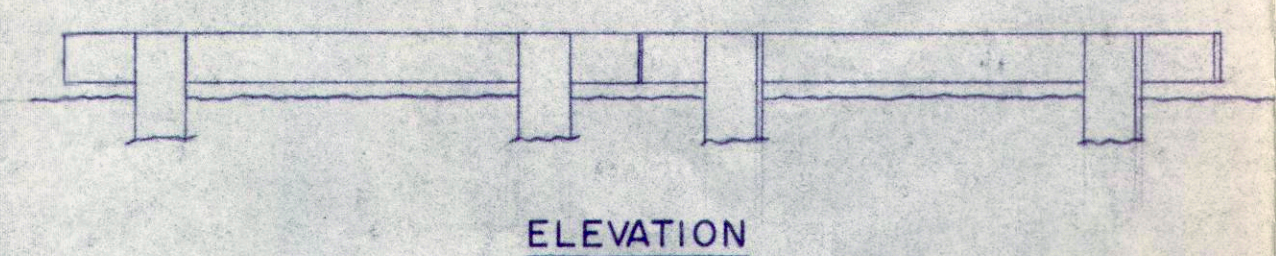


ELEVATION

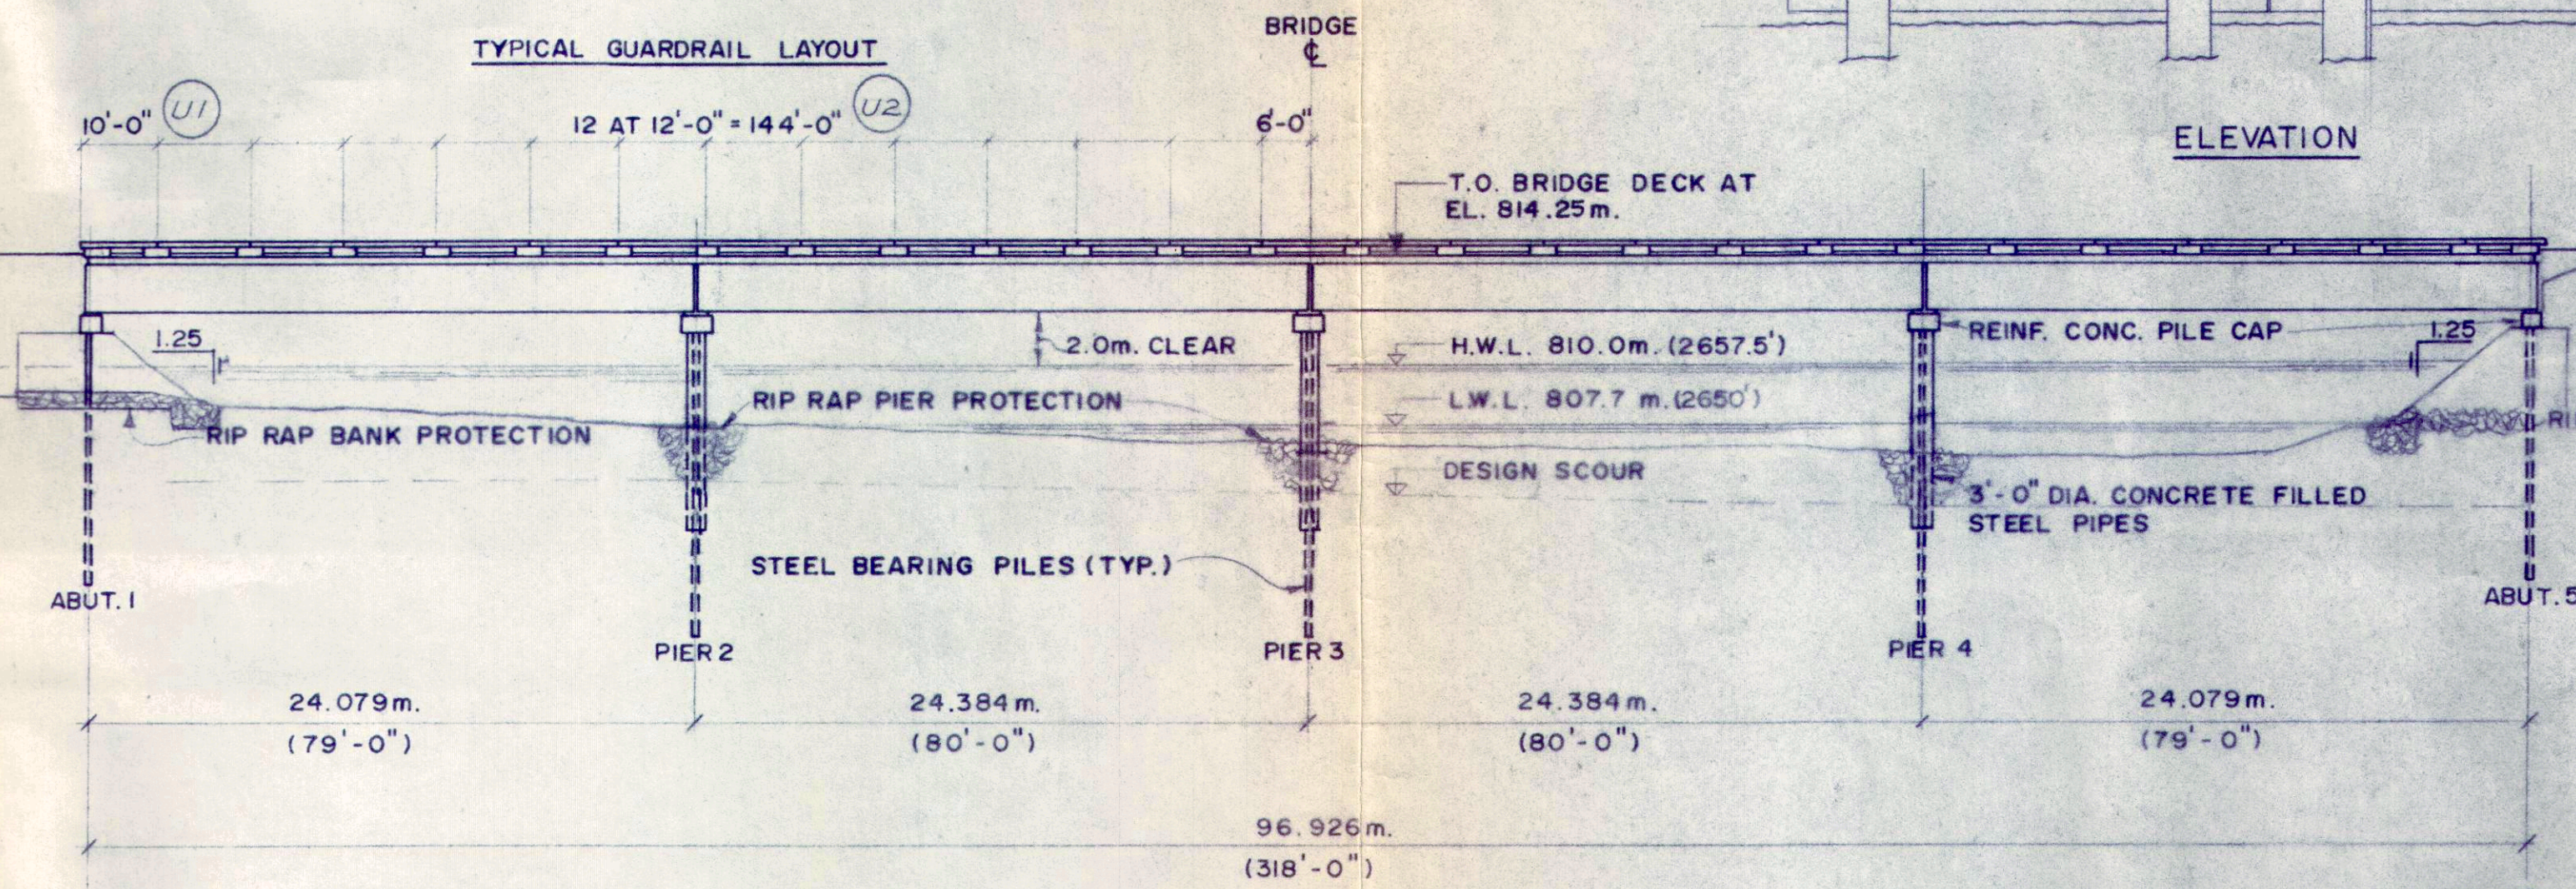

ELEVATION
SCALE 1:250

- NOTES**
- DESIGN WHEEL LOADS ON ONE GIRDER OF TWO FOR 100 TON TRUCK.
LOAD CASE 1. 36.4 36.4 28.0 28.0 10.5
2. 25.9 25.9 38.5 38.5 10.5
 - MATERIAL SPECIFICATIONS ARE GIVEN ON DWG. 1167-4.
 - SITE INFORMATION TAKEN FROM DRAWING BY CRESTBROOK FOREST INDUSTRIES LTD. DATED APRIL 26, 1982.

Structure No. N2-103
KOOTENAY-WHITETAIL FSR
km 9.5 KOOTENAY RIVER

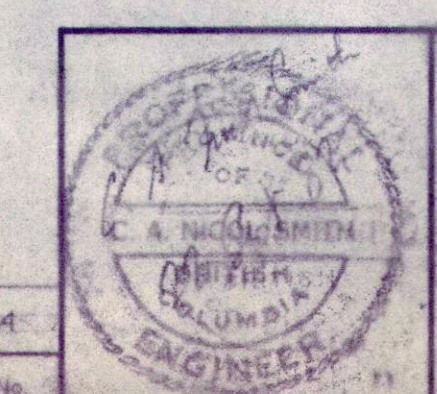

GOWER, YEUNG & ASSOCIATES LTD.
CONSULTING ENGINEERS
360, 522-7th STREET
NEW WESTMINSTER, B.C. 524-8521

CRESTBROOK FOREST INDUSTRIES LTD. FEB 16 1982

KOOTENAY II BRIDGE	DRAWN	M.L.	DATE	JUNE / 1982
	CHECKED	P	DATE	JULY / 82
GENERAL ARRANGEMENT	PROJ. No.	1167	DWG. No.	2 OF 4

OCT./82	AS BUILT	A
DATE	REVISION	No.