
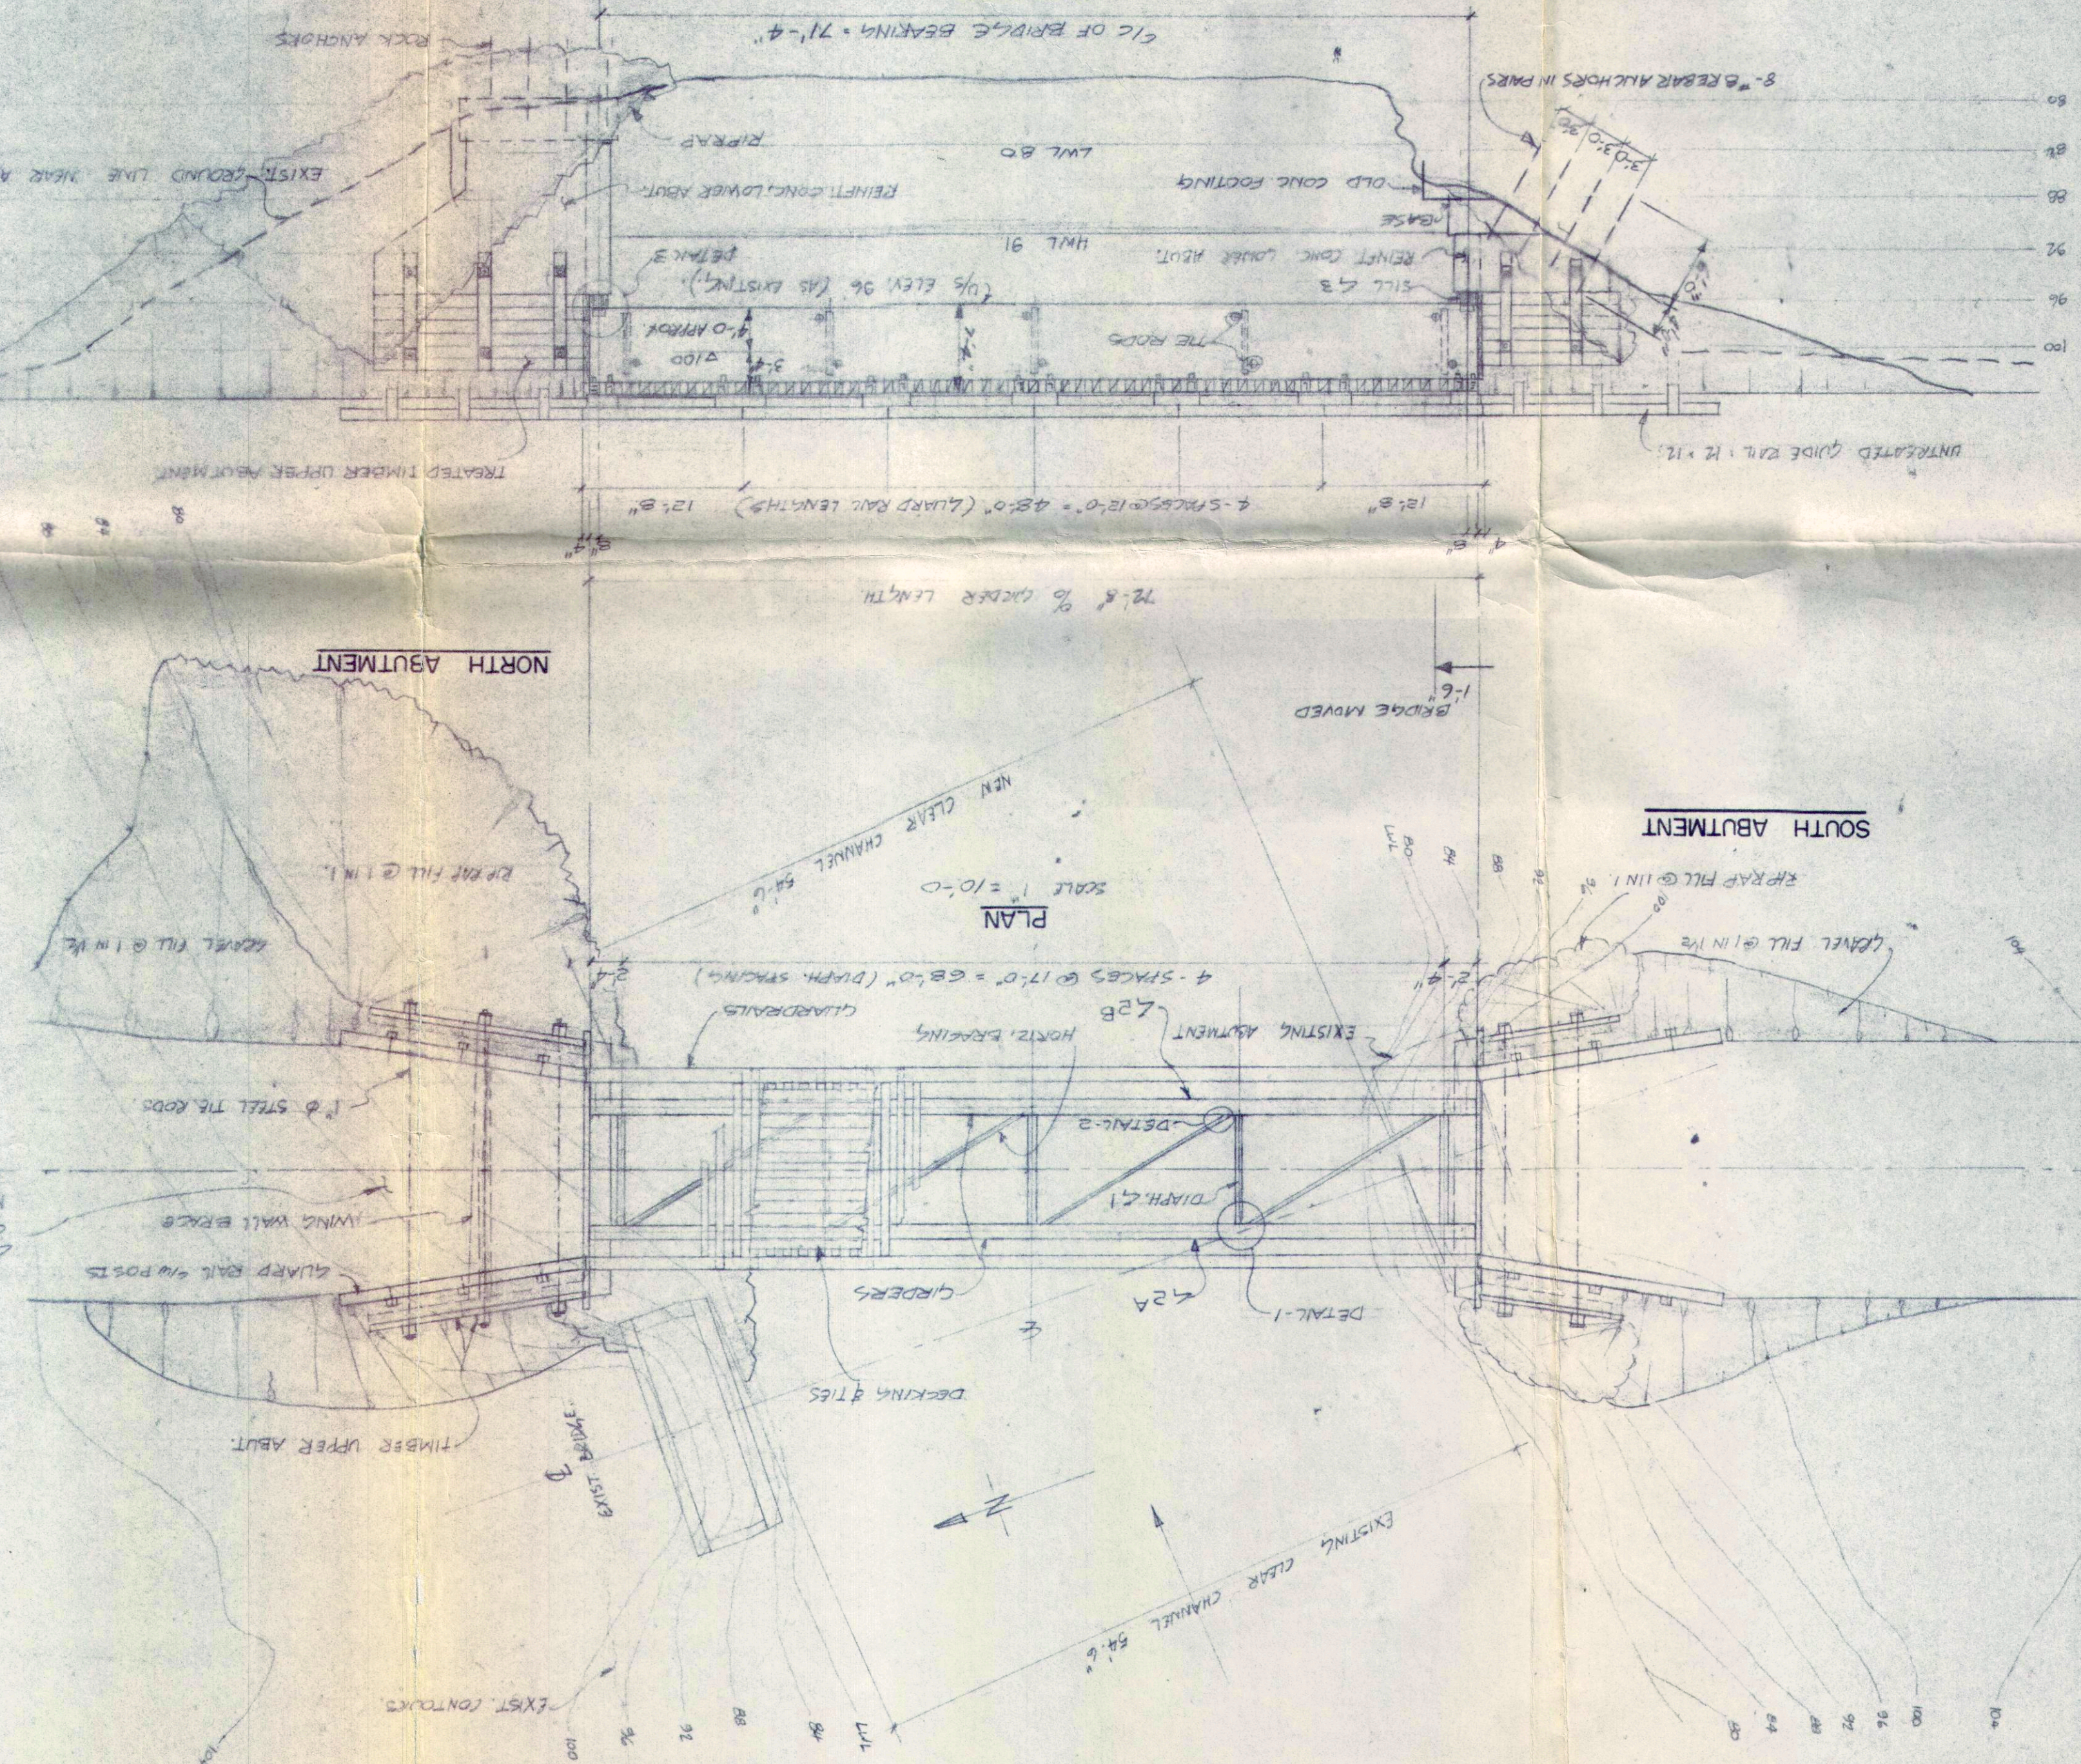






* ASSUME CROSSING TOLERANCE: 0.15' AT ELEVATION MEASUREMENTS AND UP TO 0.25' AT ELEVATION MEASUREMENTS AT THE 5' AND UP

- MATERIALS**
1. QUARD RAILS, RUBBER BLOCKS, UNTREATED WOOD - ANY SPECIES, ANY GRADE
 2. DECK, CROSS TIES, ABUTMENT PLANKS & ROADS, TREATED #1 DOUGLASS FIR
 3. GULAM: 24" x 48" DOUGLASS FIR, INDUSTRIAL FINISH, LIGHTWEIGHT GULAM, TREATED #1
 4. REINFORCING STEEL, BARRIERS ETC.: 40-21 GARDER 24" W. HOT DIP GALVANIZED
 5. HARDWARE: A 307, HOT DIP GALVANIZED
 6. CONCRETE: 3000 PSI @ 28 DAYS
 7. REINFORCING BARS: INTERMEDIATE GRADE DEFORMED BARS.

- NOTES**
1. DECK ROCK LOAD: 100 TON, 70/30 LOAD DISTRIBUTION.
 2. SITE WIDENING FROM C.I. TO C.I. FINISH - BRIDGE ROCKS 289'
 3. DATA FOR ELEVATIONS: EXISTING BRIDGE DATA @ 100.00.

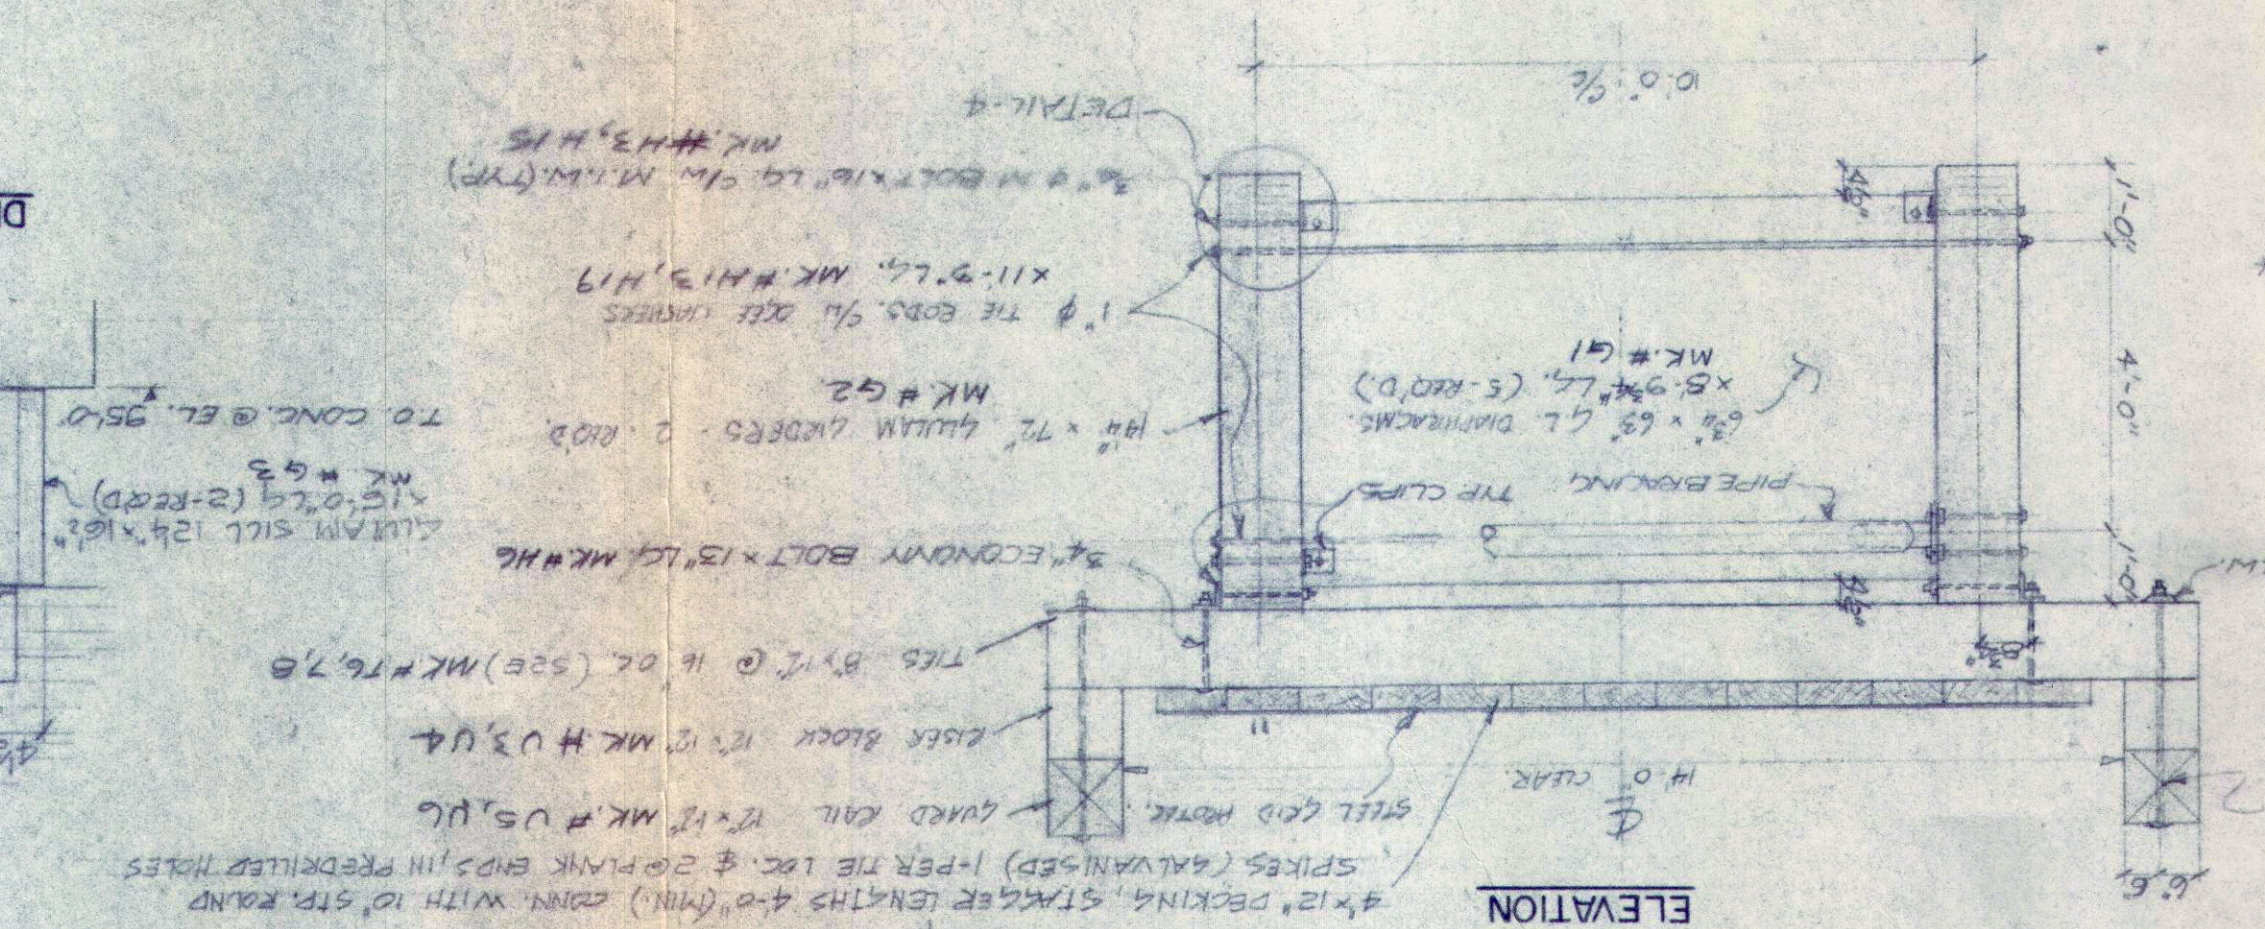

GENERAL ARRANGEMENT		GOWER, YEUNG & ASSOCIATES LTD.	
PROJECT NO. 1218	DATE MARCH 1982	NEW WESTMINSTER, B.C. 524-8521	CONSULTING ENGINEERS
DRAWN BY	CHECKED BY	FINDLAY & CO. ENGINEERS	
DATE MARCH 5/82	DATE MARCH 1982	CRESTBROOK INDUSTRIES	

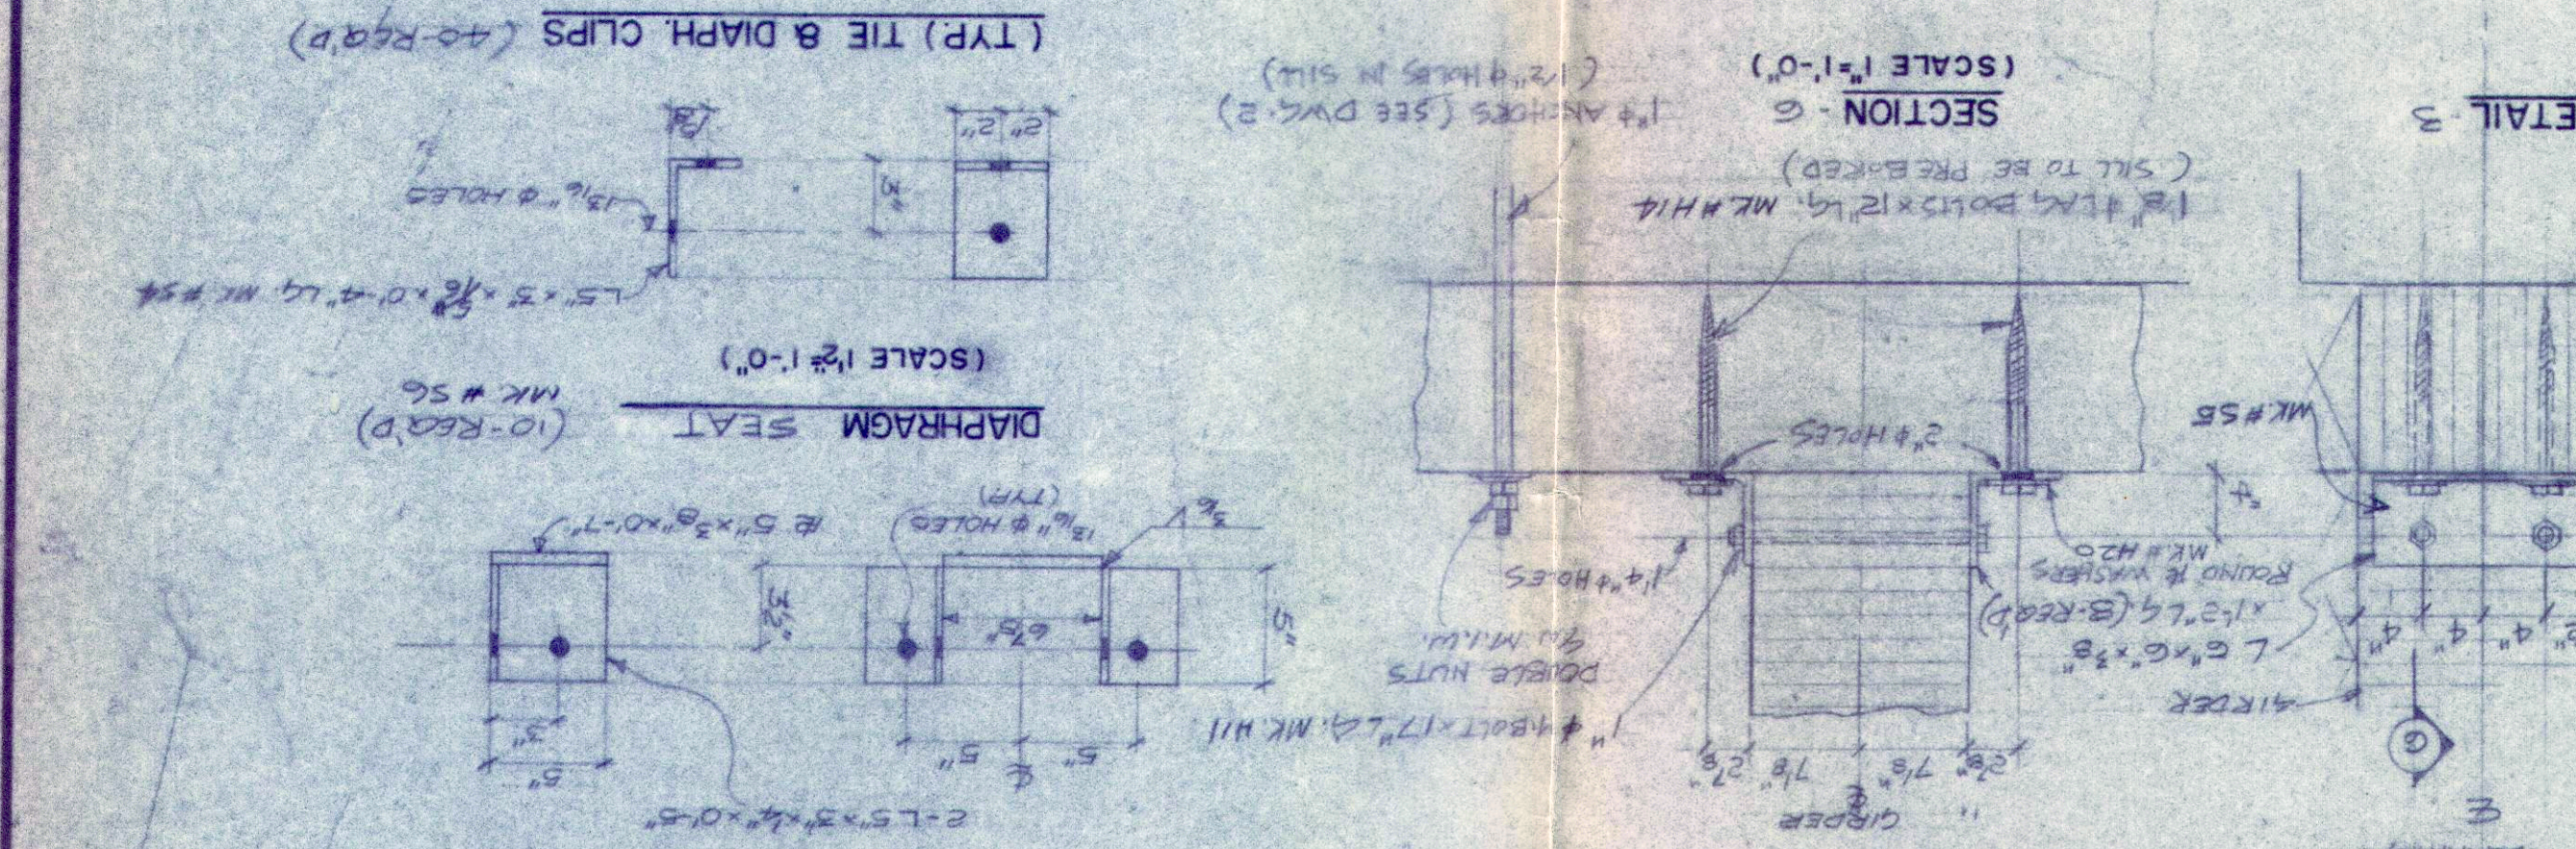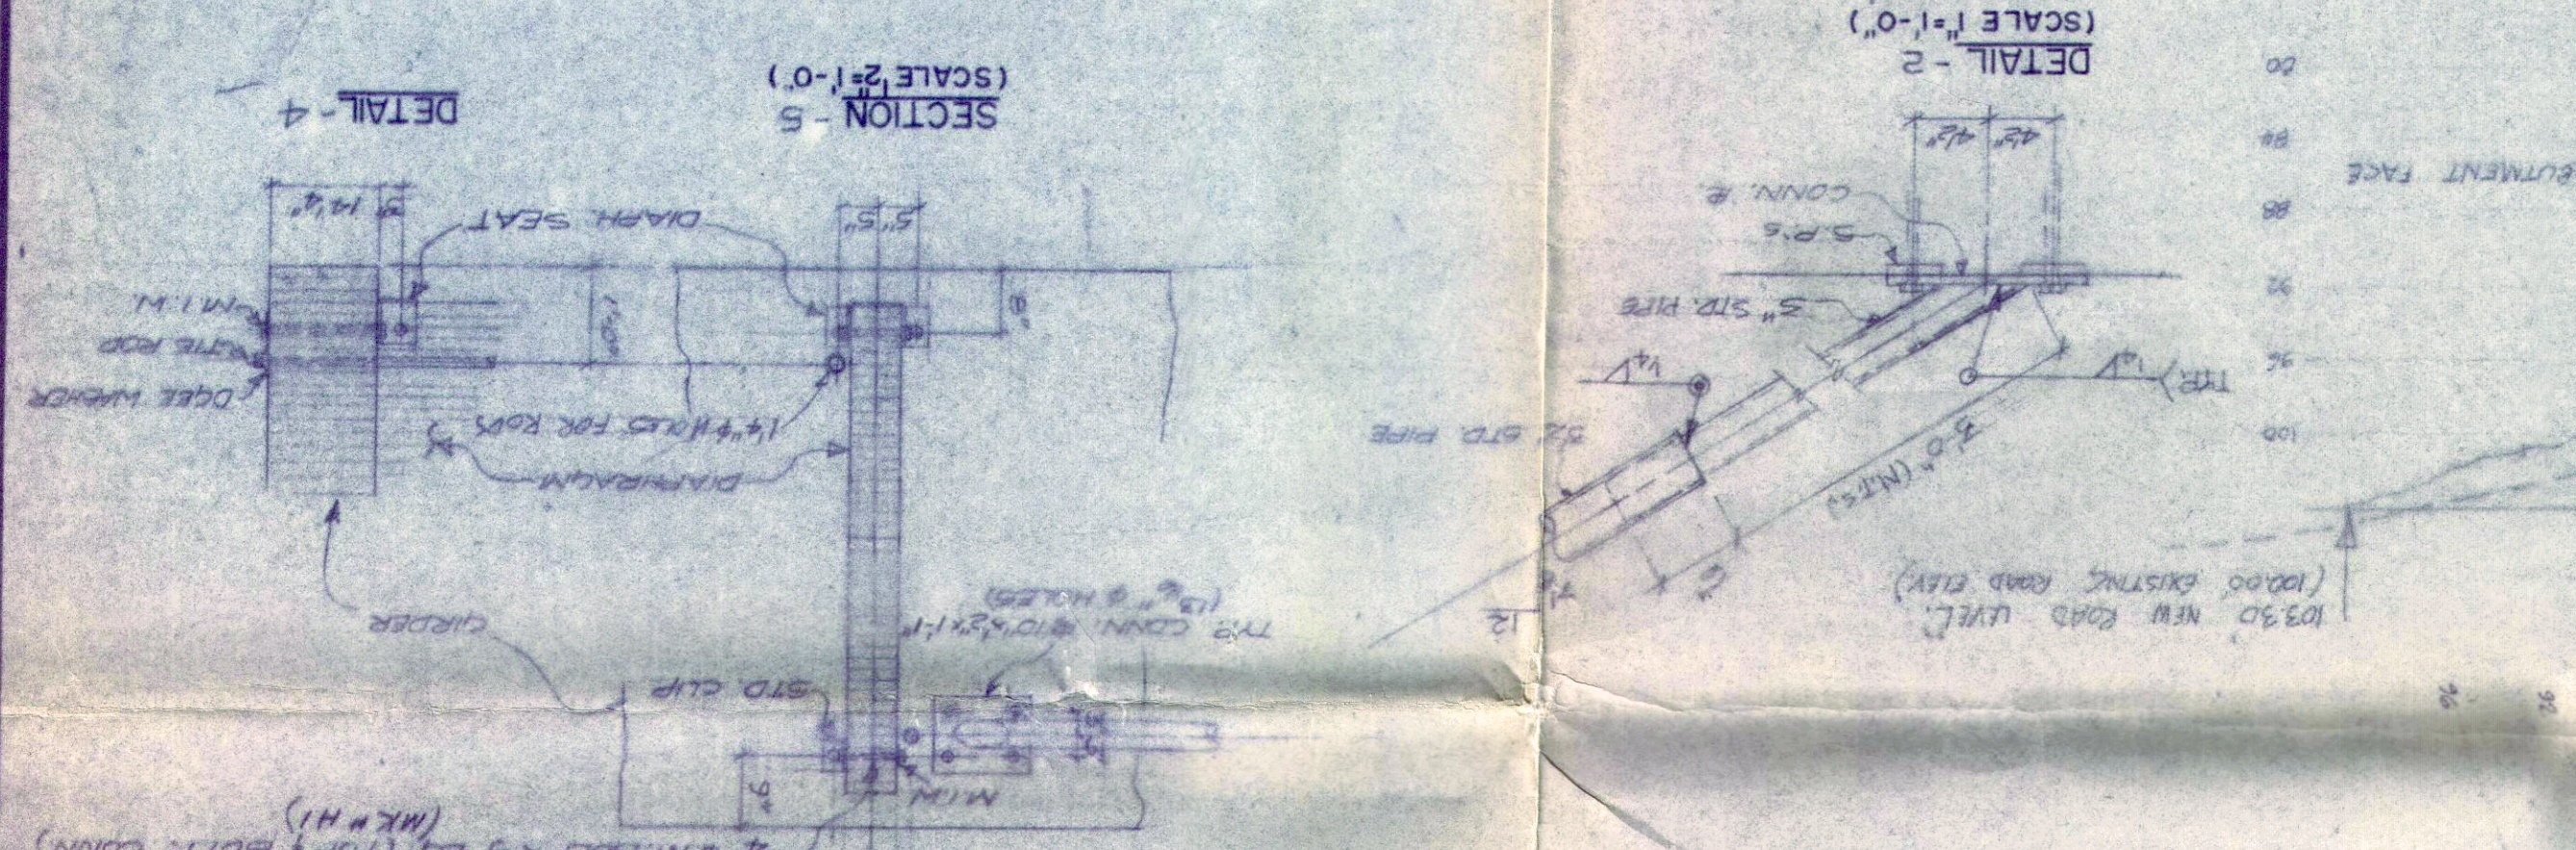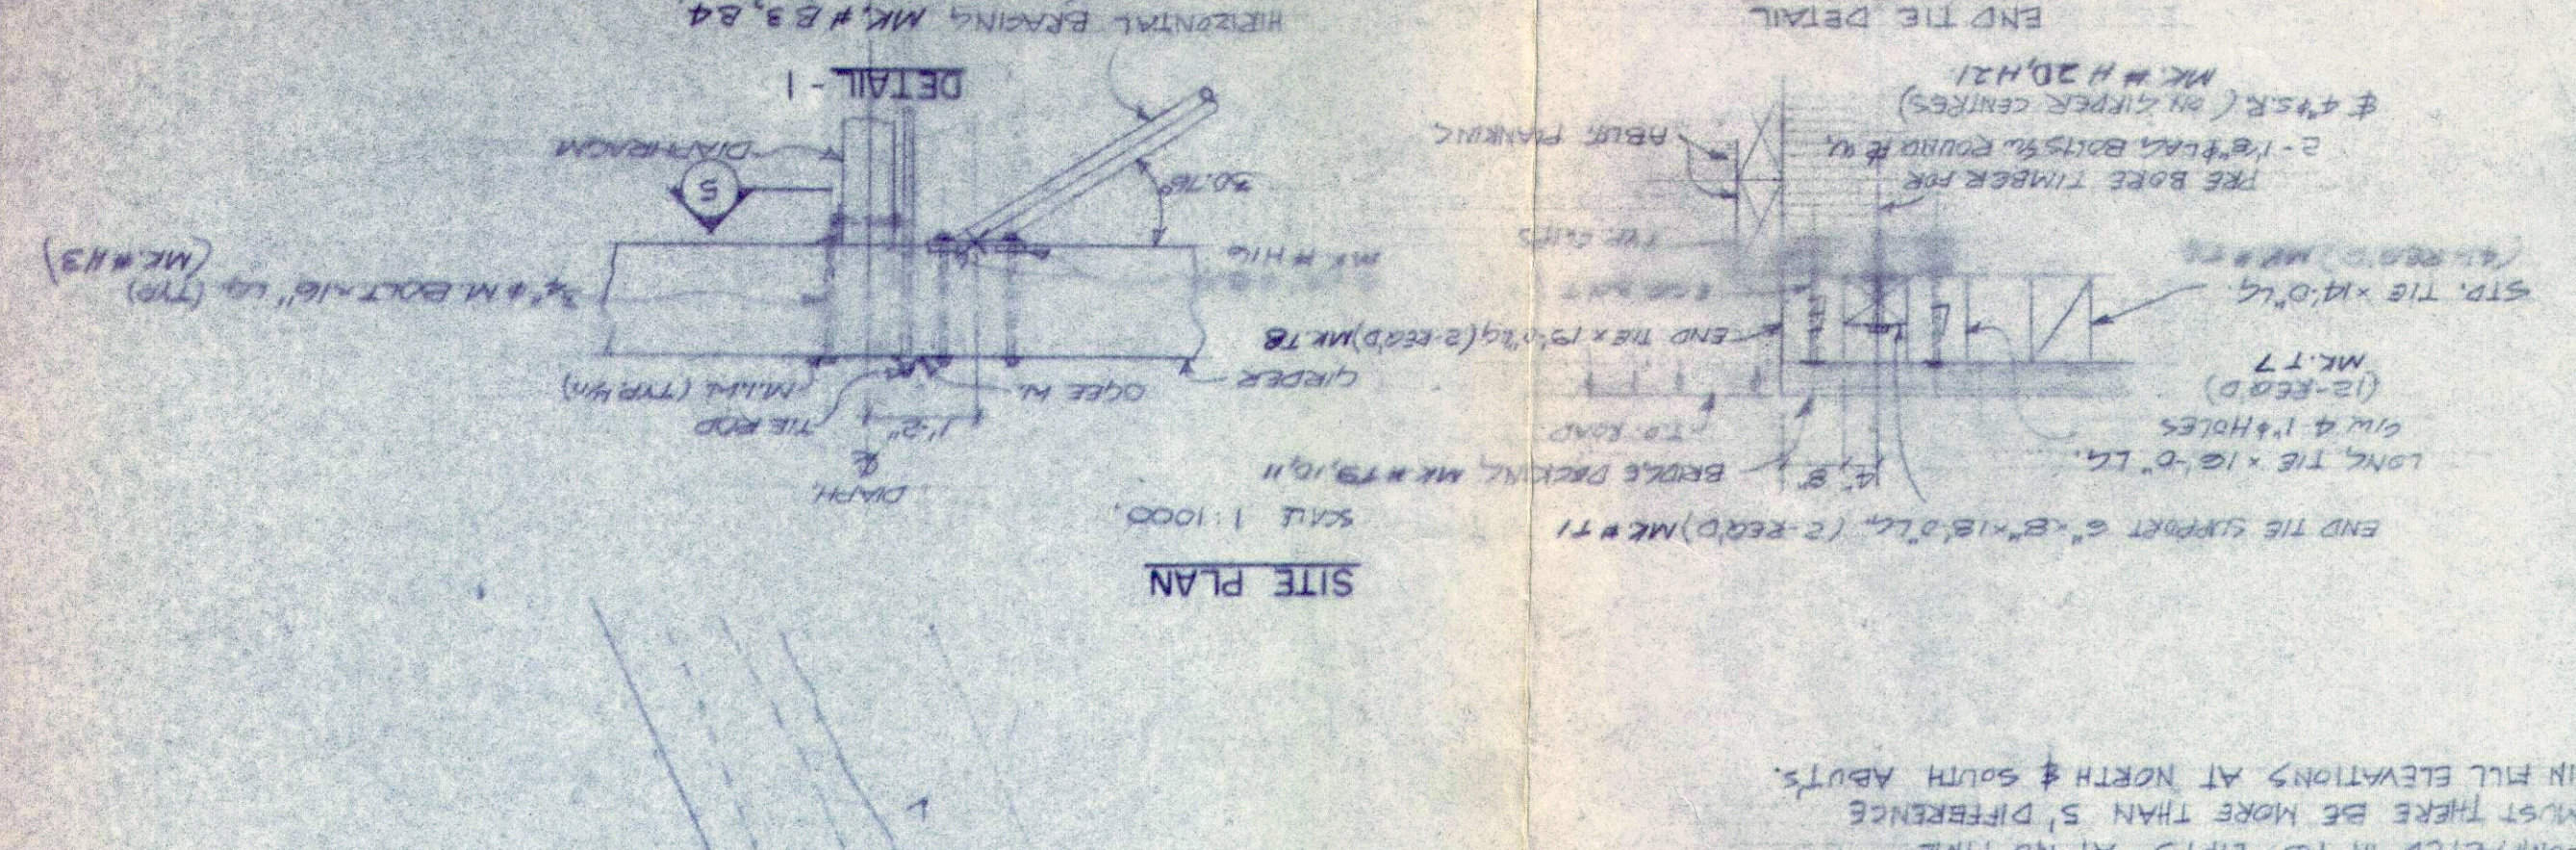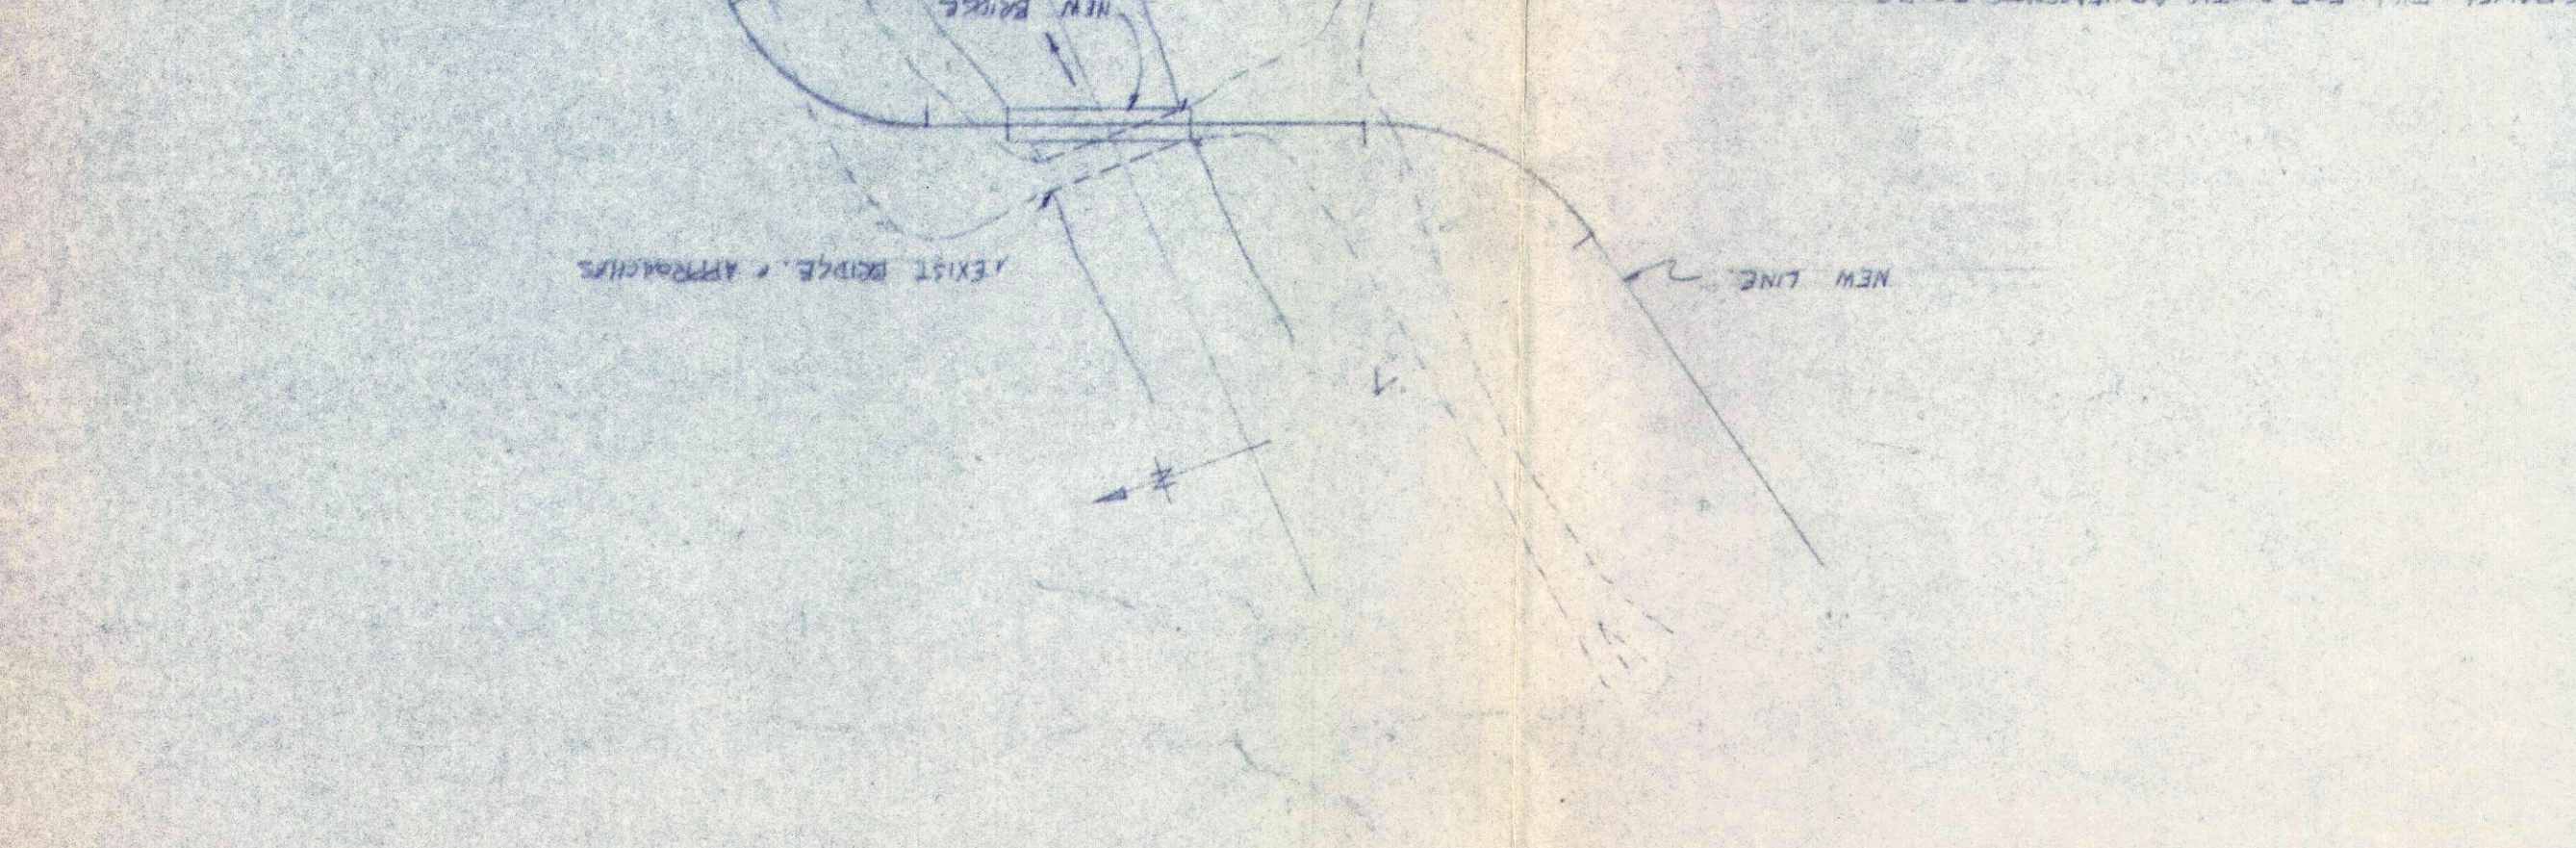

GOWER, YEUNG &
ASSOCIATES LTD.
CONSULTING ENGINEERS
360, 522 - 7th STREET
NEW WESTMINSTER, B.C. 524-8521

DATE	REVISIONS	NO.
10/20/82	REWORKING	B
10/20/82	WORKING AS BUILT	C
10/20/82	N.BUILD. REVISID AS BUILT	D

