


Ten Mile Lake

- PARK SYMBOLS
- Wood Corral
 - Wood & Garbage Corral
 - Garbage Corral
 - Pit Toilet
 - Info Shelter
 - Horseshoe Pits
 - Change House
 - Beach Shower
 - Stairs
 - Play Structure
 - Gate
 - Water Tap
 - Fountain
 - Hydrant
 - Building (Toilet, Showers, etc.)

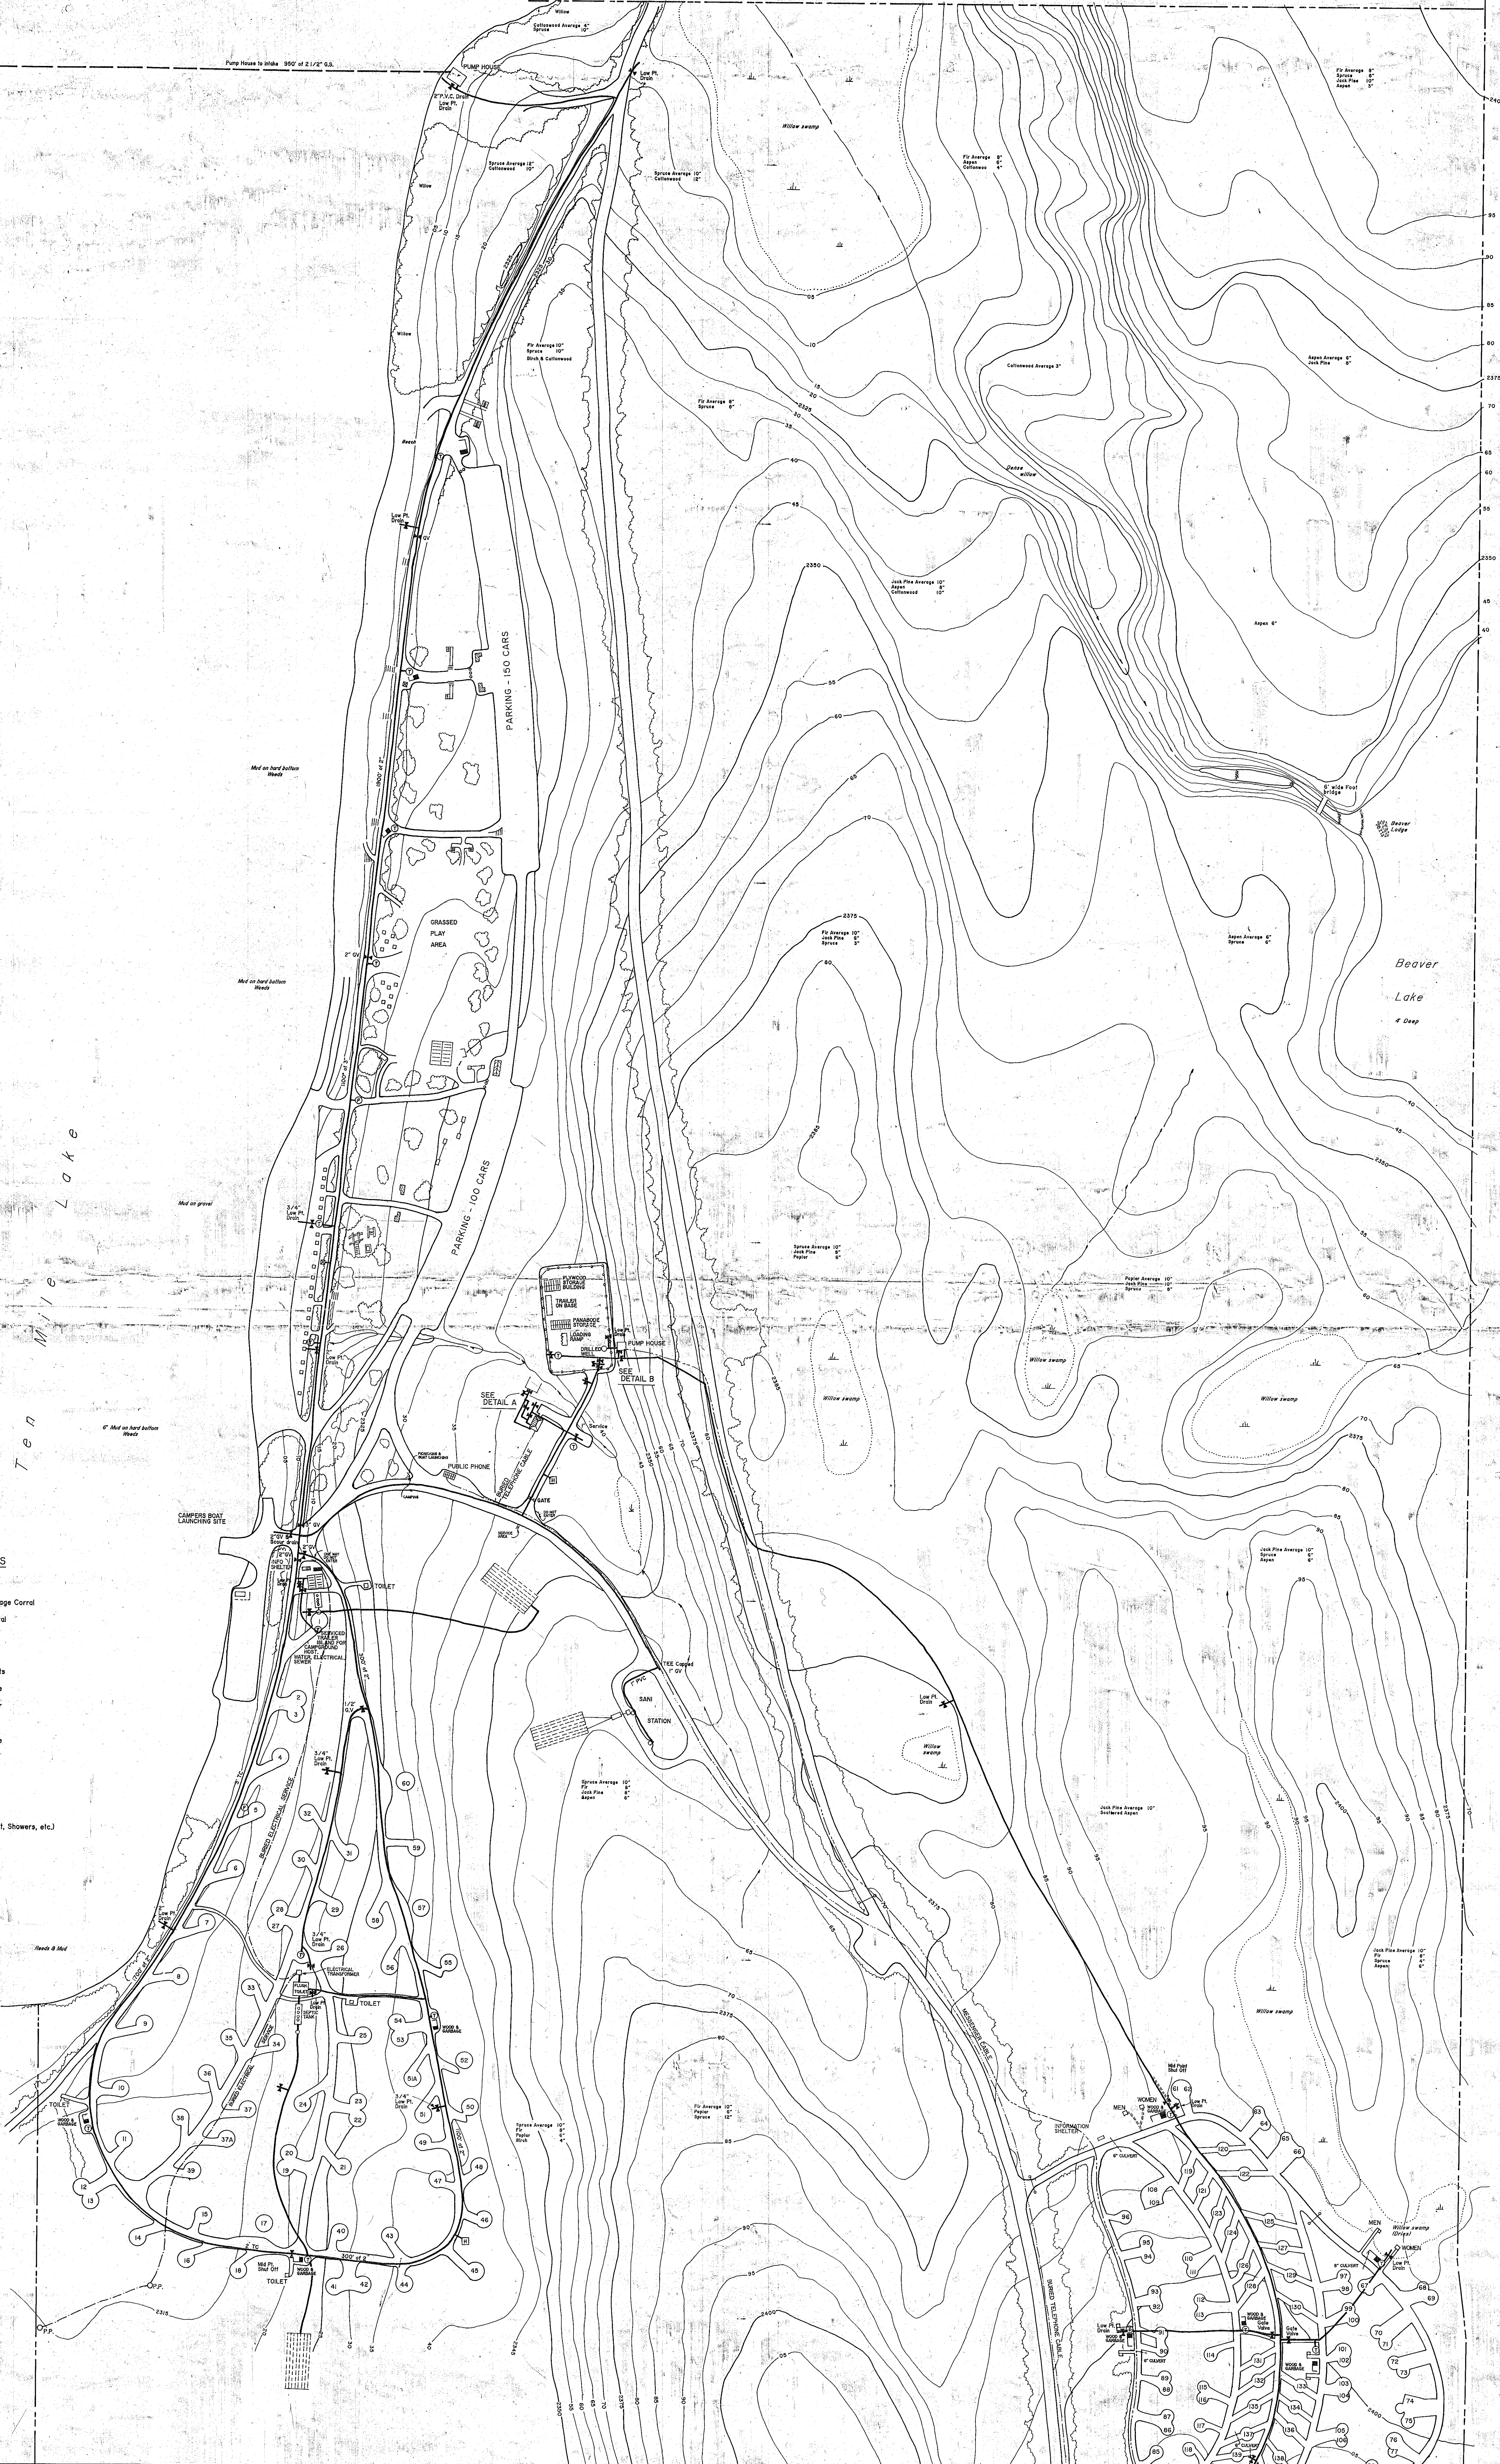

DETAIL A

DETAIL B

DETAIL C

100 0 100 200

Scale: 1 inch equals 100 feet

TEN MILE LAKE PARK

TOPOGRAPHY - DEVELOPMENT (as built 1990)

DRAWING NO.