


Date: 2019/12/04

11-W0560 Block A - map showing Sep 2018 Imagery - 2 potential choices for Replacement Area shown in red

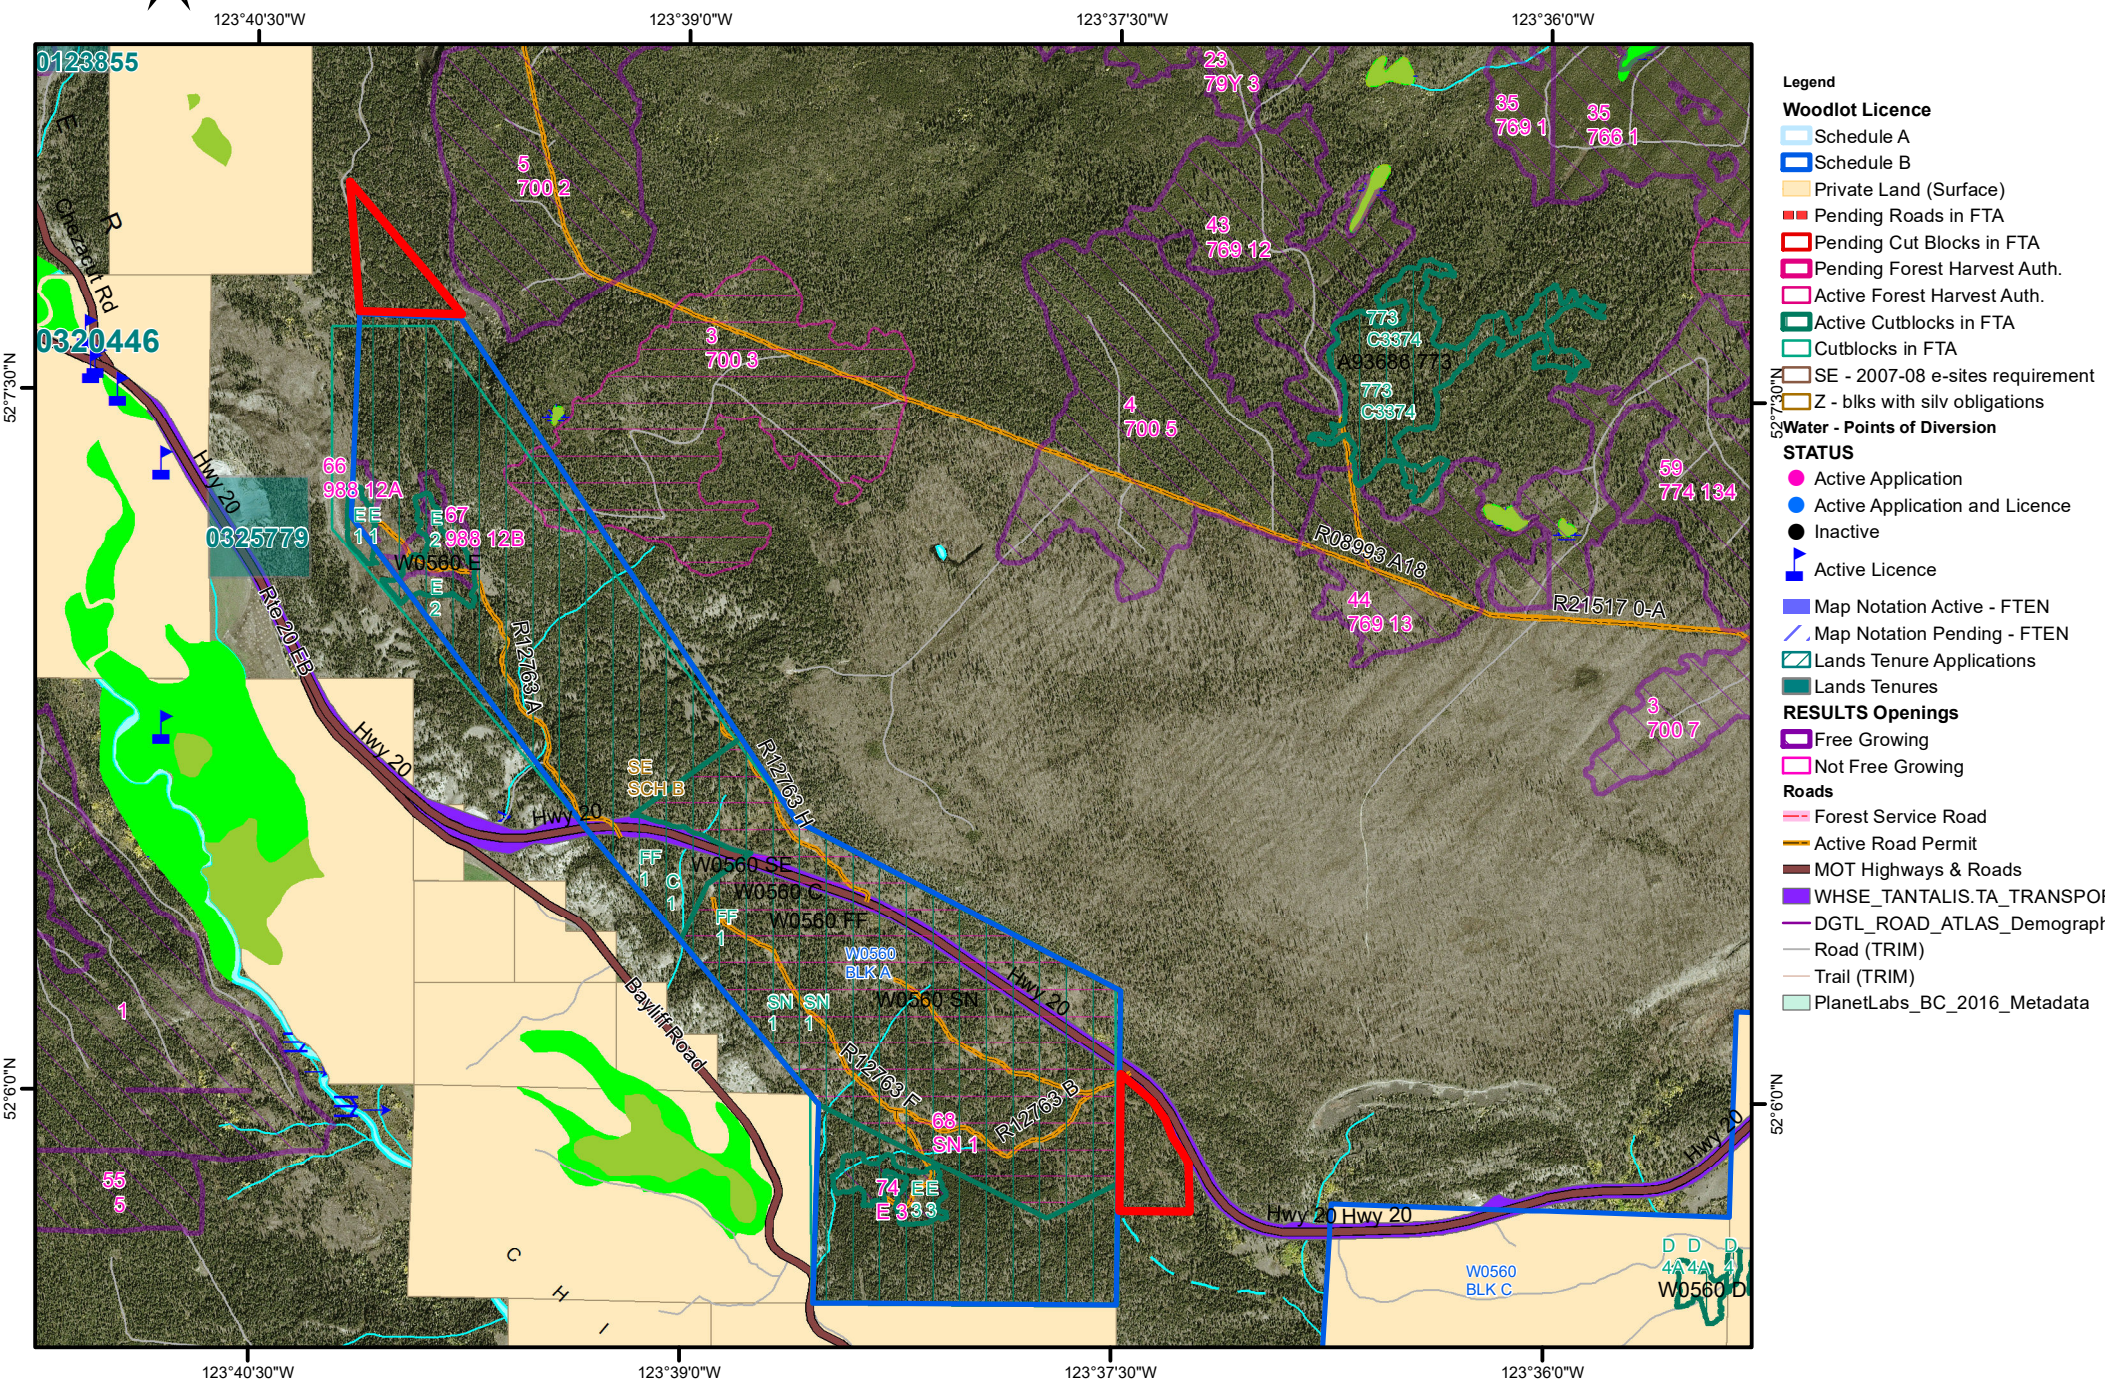

Scale: 1:30,000