

BCTS

KOOTENAY BUSINESS AREA
GRAND FORKS FIELD TEAM

CRUISE MAP

PROPOSED ☐
FINAL ☒

TSL: TA0487 BLK: 2 UBI: BF6CL

LOCATION: Lost Horse Crouse Cr
MAPSHEET/OPENING NO: 082E036
BIOGEOCLIMATIC ZONE:
IDFdm1/MSdm1
REGION: 24 COMP: 1
PSYU: Kettle FIZ: E
ELEVATION: 920-1060 RANGE: 140
LATITUDE: 49° 23' 34.4" N
LONGITUDE: 118° 55' 27.9" W
EASTING: 360356
NORTHING: 5472914
UTM ZONE: 11 NAD: 83

SCALE 1:5000




DEC.:
17° 21'



DATE: January 07, 2021 DRAWN BY: LB

(Area in ha)	CRUISE AND AREA SUMMARY			
TIMBER TYPE SUMMARY	-	-	-	TOTAL
TYPE IX	6.6			6.6
NET AREA	6.6	0.0	0.0	6.6
No Harvest Zone (NHZ)	0.0			0.0
Riparian Reserve (RRZ)	0.0			0.0
Wildlife Tree Retention Area (WTRA)	1.4			1.4
Rock (NPR)	0.0			0.0
Roads (NPunn)	0.9			0.9
Landings (NPunn)	0.0			0.0
Trails (NPunn)	0.0			0.0
NPWater/Swamp/Wet (NPS)	0.0			0.0
GROSS BLOCK AREA	9.0	0.0	0.0	9.0

Merchantable area has changed from Cruise Plan to Crusie Final, due to First Nations request for buffers around in block Streams and NCDs. An additional merchantable area change occurred as the Mule Deer Winter Range intercept cover number was updated after the Cruise was complete.

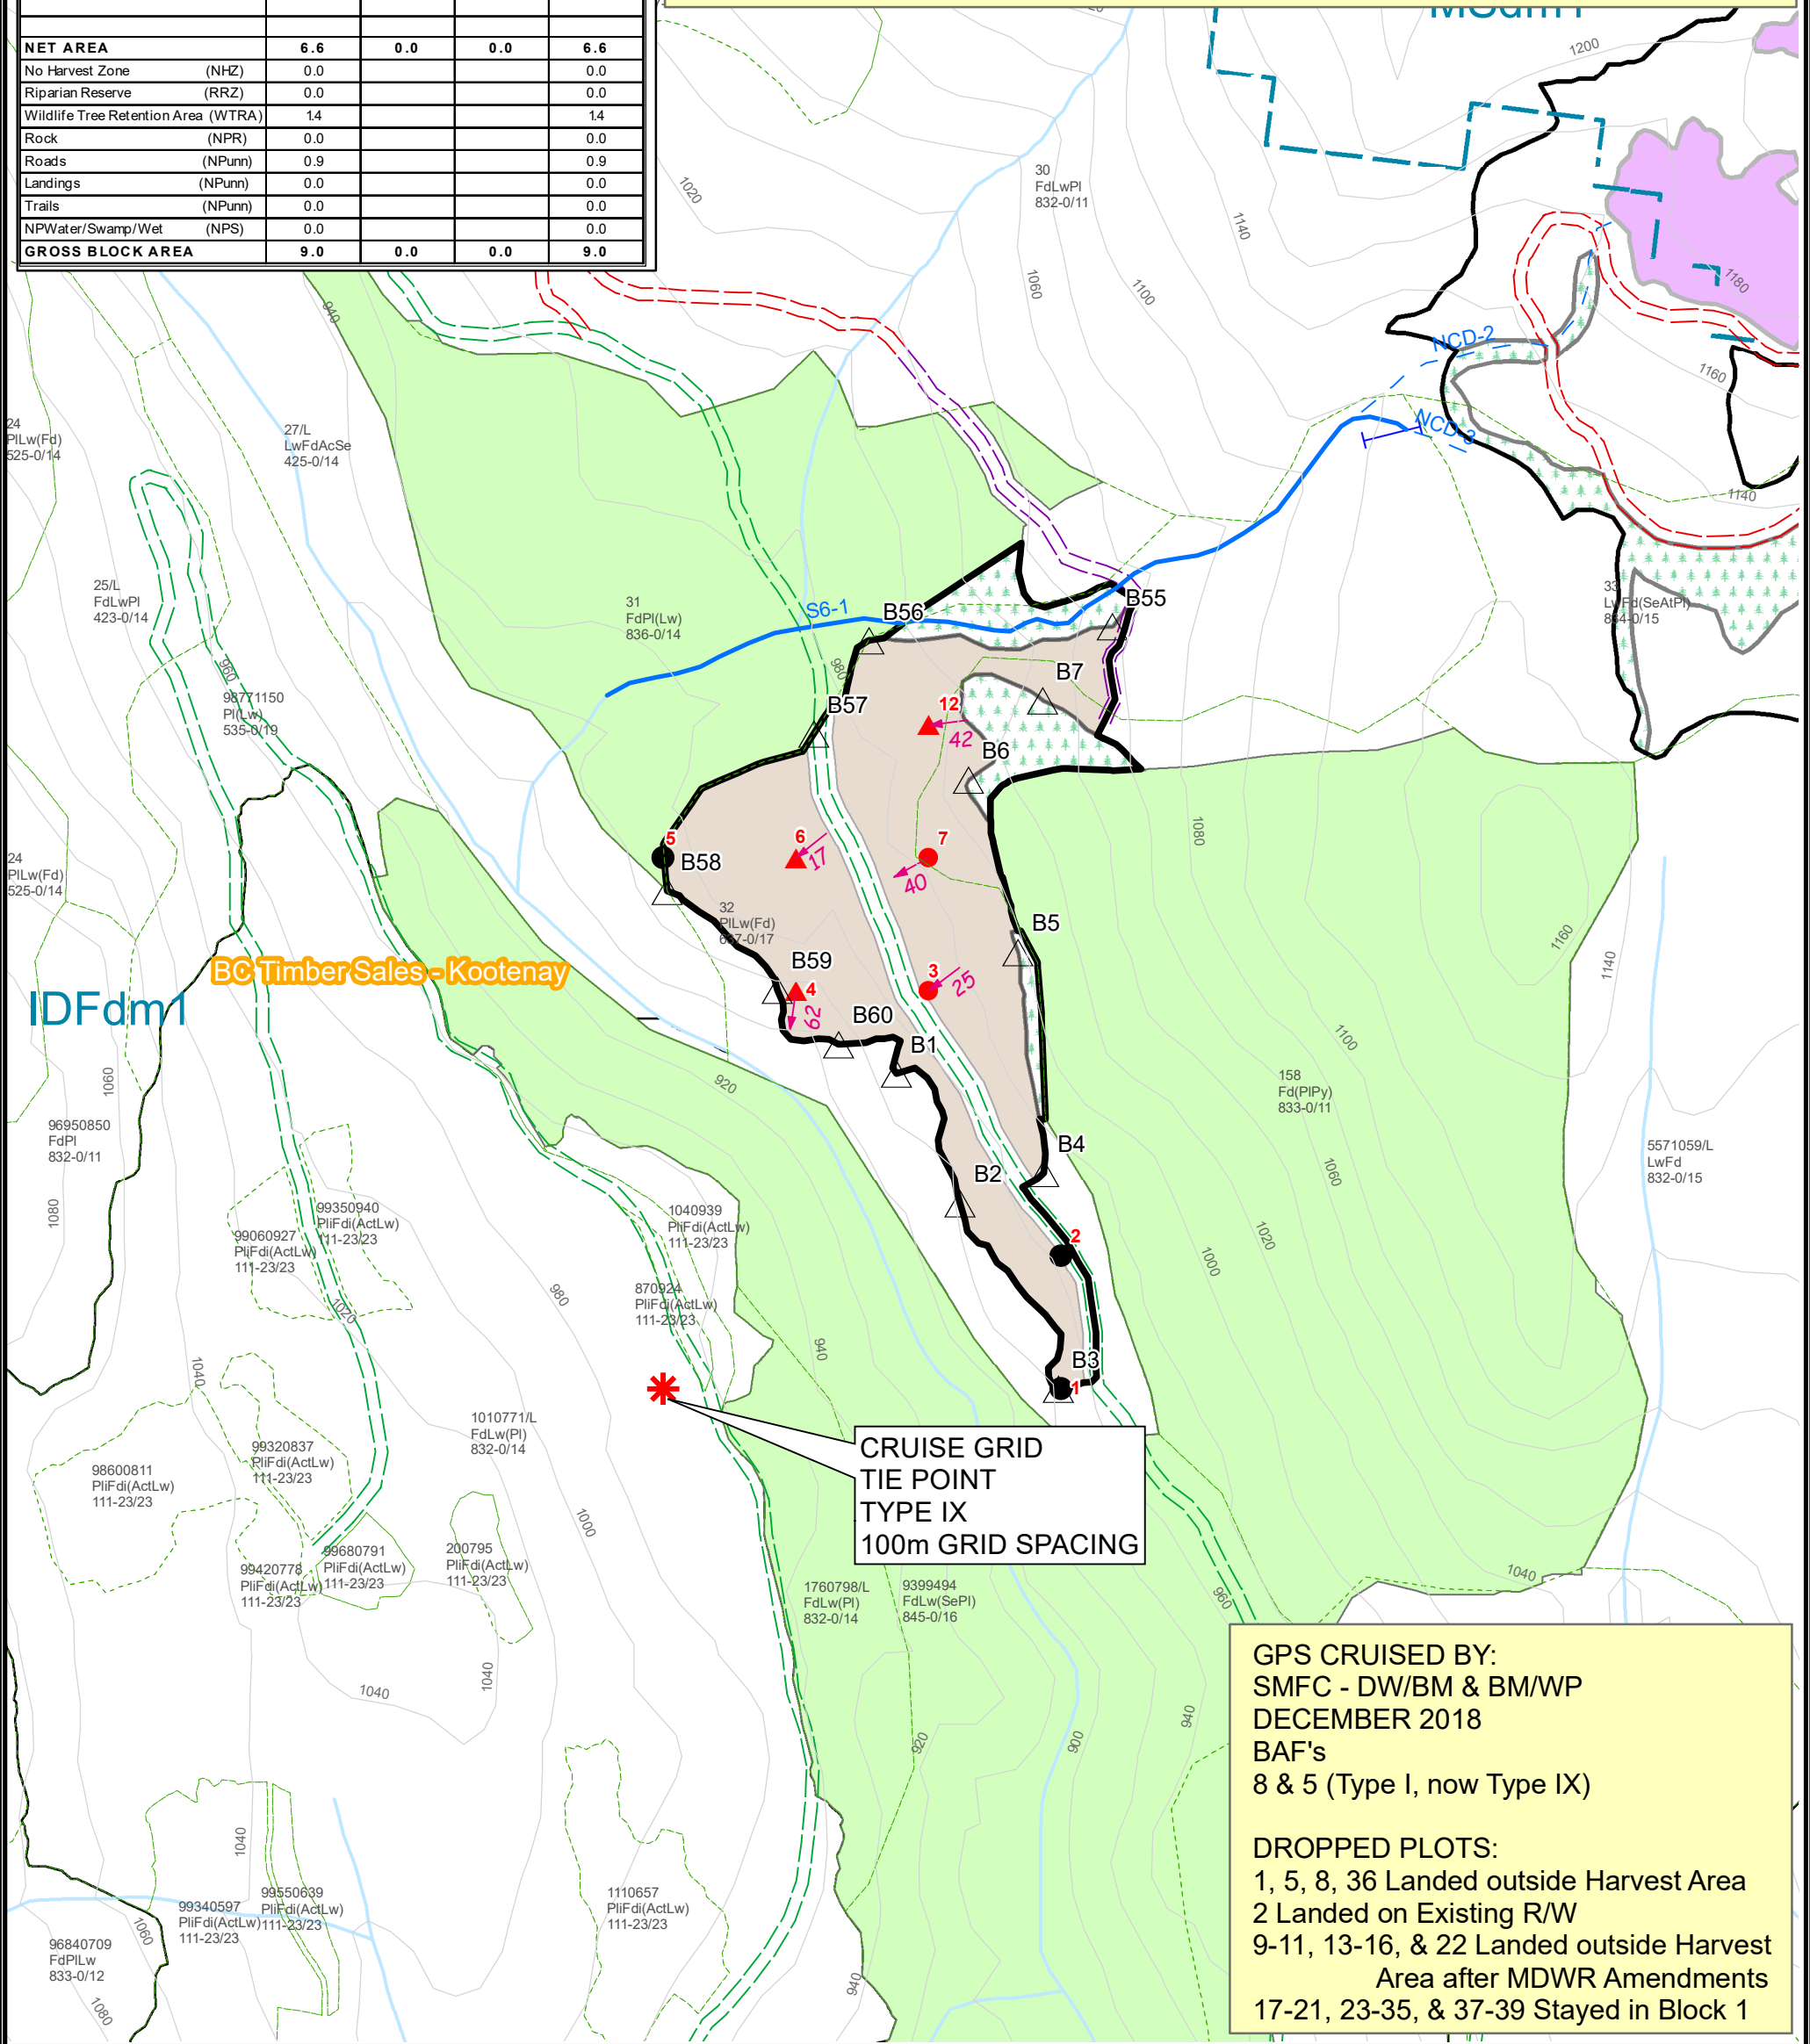

GPS CRUISED BY:
SMFC - DW/BM & BM/WP
DECEMBER 2018
BAF's
8 & 5 (Type I, now Type IX)

DROPPED PLOTS:
1, 5, 8, 36 Landed outside Harvest Area
2 Landed on Existing R/W
9-11, 13-16, & 22 Landed outside Harvest Area after MDWR Amendments
17-21, 23-35, & 37-39 Stayed in Block 1

Block Boundary
Adjacent Block Boundary
Stratum S.U. Boundary
Treatment Unit Boundary
Forest Cover Type Line
Wildlife Tree Retention Area
Wildlife Habitat Area
Intermediate Contour
Index Contour
Falling Corner / Station
Cruise POC/ Drop Plot
Measure Plot/ Count Plot
Cruise Grid Tie Point

Highway's Road
Existing Road
Tolko or Interfor Existing Road
Upgrade Perm road LT
New Construction Perm LT
New Construction Temp ST
Upgrade Temp Road
Existing Trail
Permanent Trail
Temporary Trail
Existing Landing/Tower
Proposed Landing/Tower
Temporary Landing/Tower

OGMA
Existing Heli Landing
Proposed Heli Landing
Temporary Heli Landing
Culvert / Sized x100 (Exist./Prop.)
Skid Crossing/Skid Bridge
Skid Crossing/Skid Culvert
Bridge (Exist./Prop.)
Embankment
Rock Outcrop
Gully
Ridge
Wet Draw

Private Land
Riparian Management Zone
Riparian Reserve Zone
No Machine Zone
No Harvest Zone
Immature/Mature Leave
Long Term Retention Stream
Stream Classification/ID.
Non Classified Drainage
Lake
Wetland (Class)

Swamp/ Seepage Areas
Reference Tree
Blowdown
Slope
Slide
Avalanche Chute
Utility Line / Pipeline
Railroad
Fence
Cattleguard
Gate
NPnat