**BCTS**

**KOOTENAY BUSINESS AREA**
**GRAND FORKS FIELD TEAM**

# CRUISE MAP

PROPOSED ☐
FINAL ☒

TSL: TA0487 BLK: 5 UBI: BF6CG

LOCATION: Lost Horse Crouse Cr
MAPSHEET/OPENING NO: 082E036
BIOGEOCLIMATIC ZONE: IDFdm1
REGION: 24 COMP: 17
PSYU: Kettle FIZ: E

ELEVATION: 930 - 1130 RANGE: 200
LATITUDE: 49° 23' 36.999" N
LONGITUDE: 118° 53' 48.030" W
EASTING: 362372.683108
NORTHING:5472942.830435
UTM ZONE: 11 NAD: 83

SCALE 1:5000

0 45 90 180 270 360

N

DEC.: 15° 12'

Cabin Forestry

DATE: February 14, 2019 DRAWN BY: LB

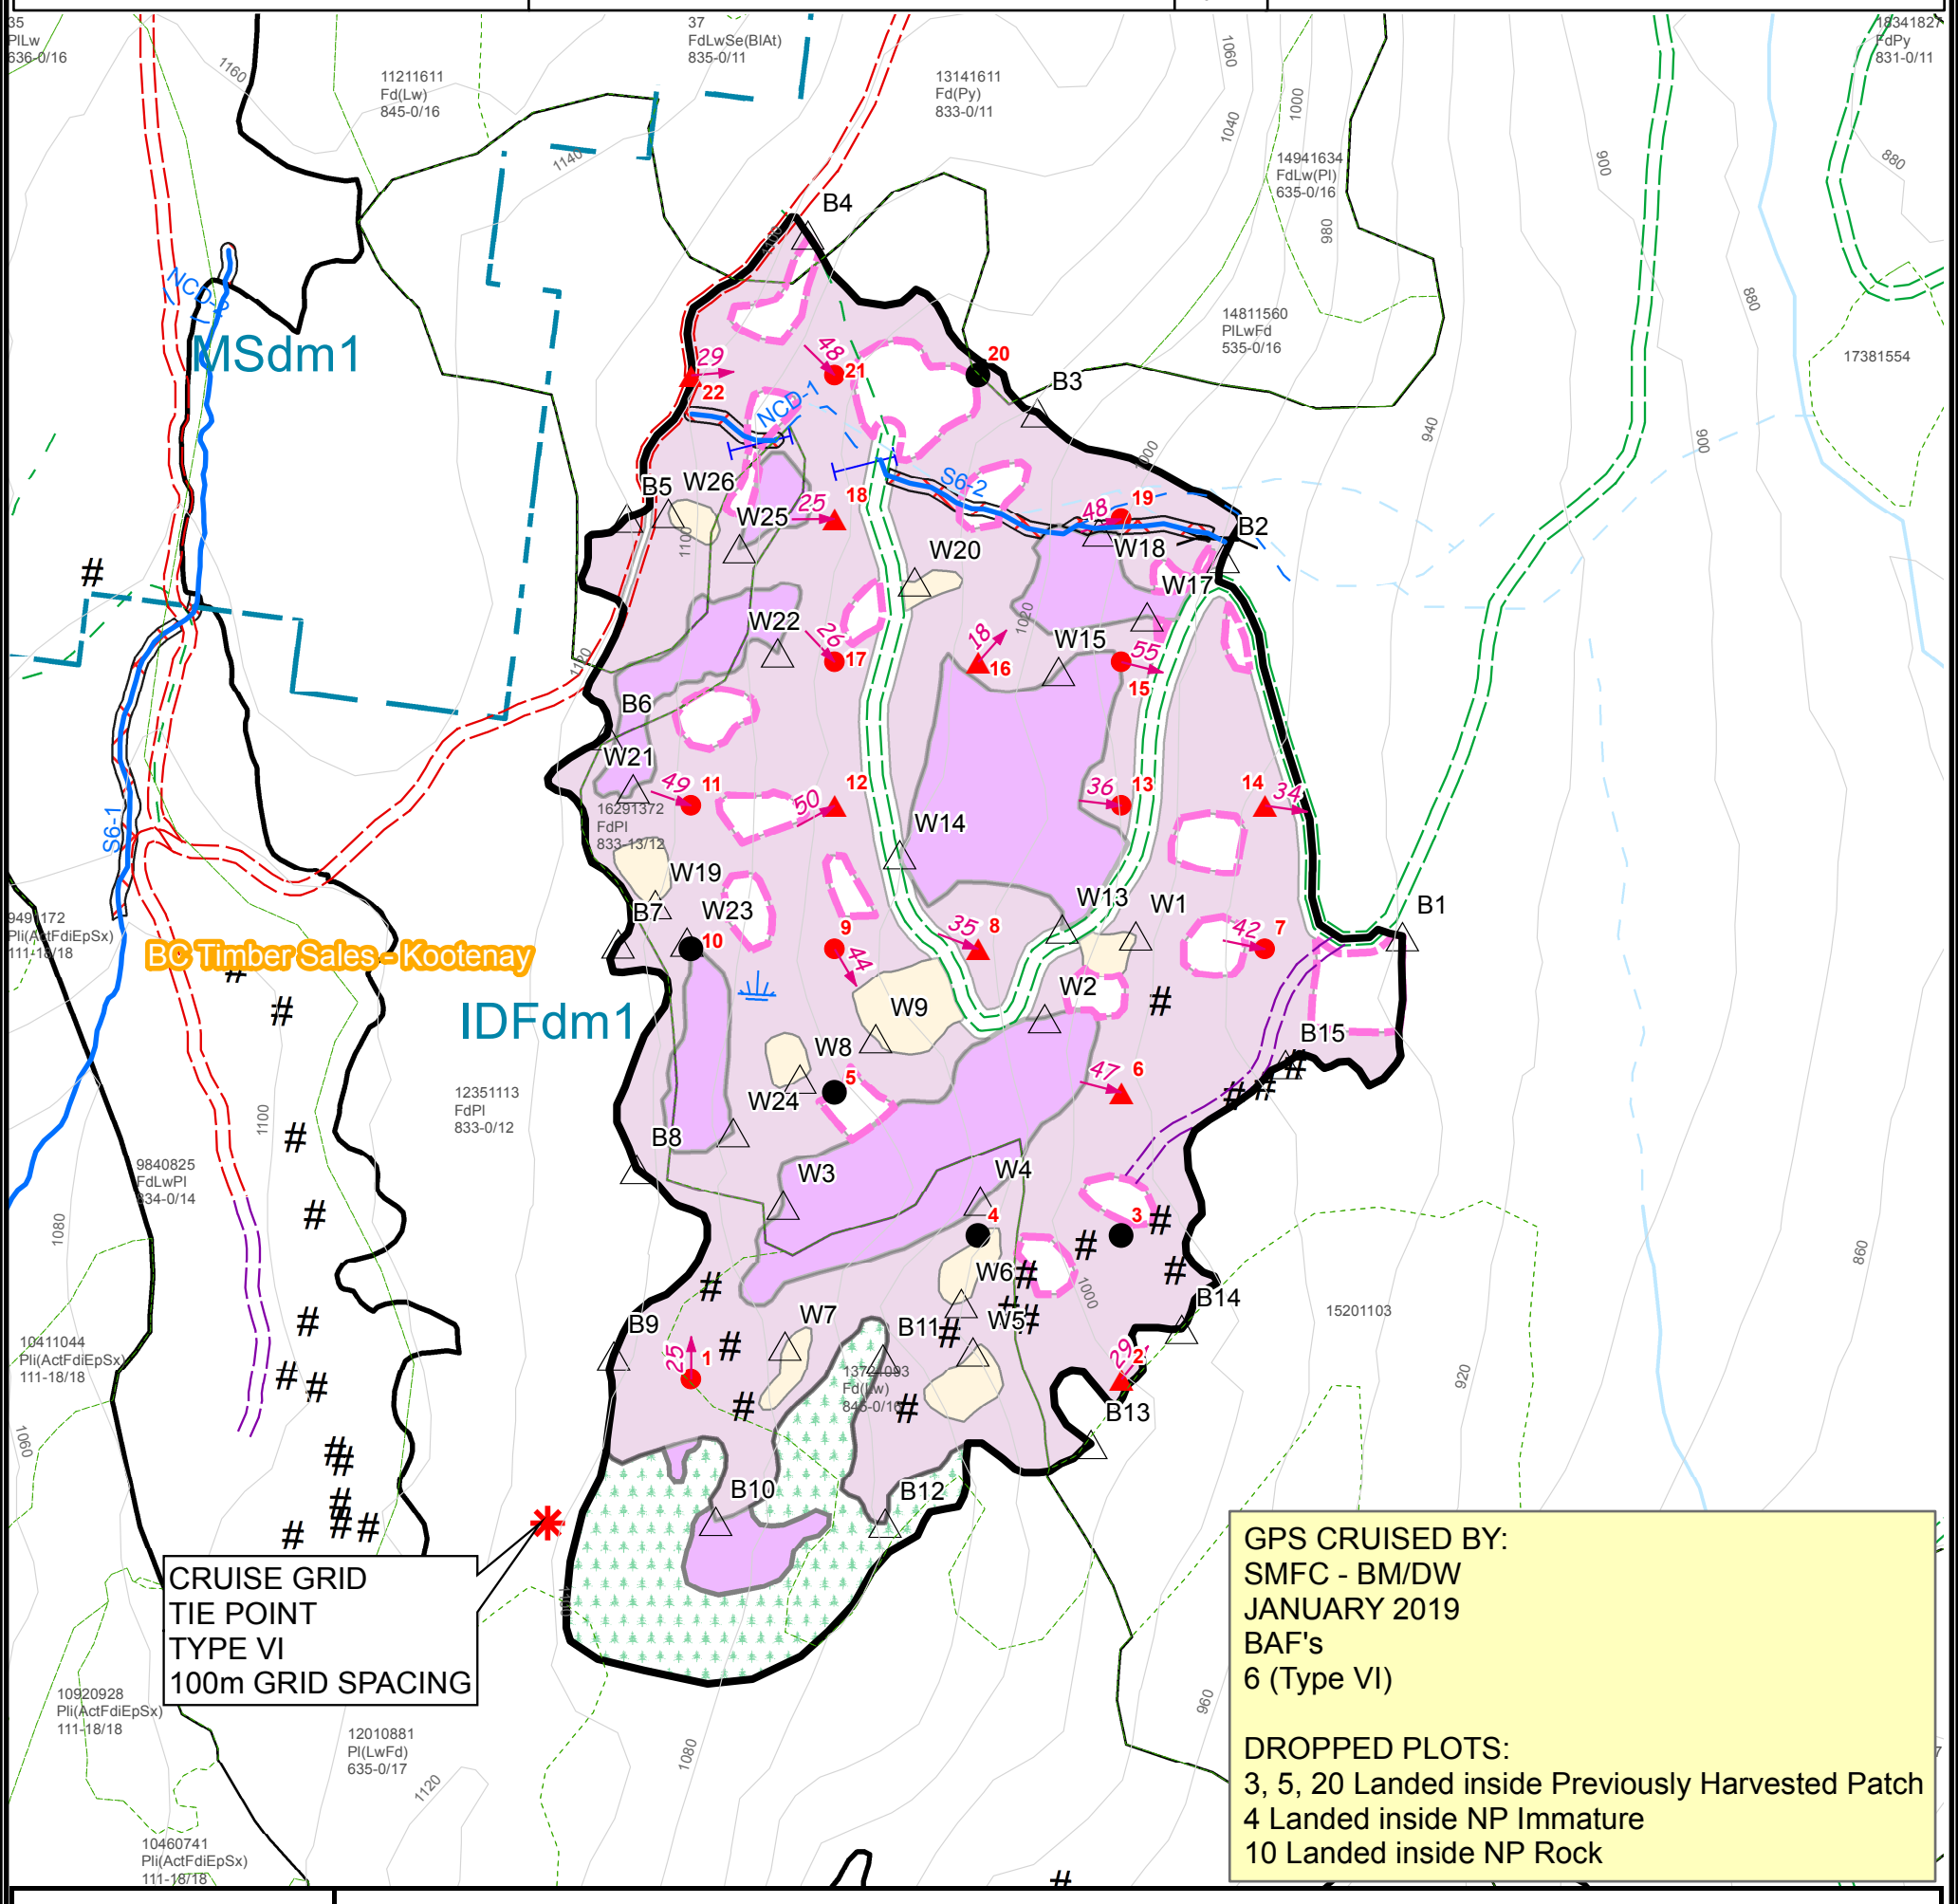


GPS CRUISED BY:
SMFC - BM/DW
JANUARY 2019
BAF's
6 (Type VI)

DROPPED PLOTS:
3, 5, 20 Landed inside Previously Harvested Patch
4 Landed inside NP Immature
10 Landed inside NP Rock

| (Area in ha) | CRUISE AND AREA SUMMARY | | | | | | | | | | | | |
|---|---|---|---|---|---|---|---|---|---|---|---|---|---|
| **TIMBER TYPE SUMMARY** | - | - | - | - | - | - | - | - | - | - | - | - | **TOTAL** |
| TYPE VI | 21.2 | | | | | | | | | | | | 21.2 |
| Previously Harvested Patches | 2.7 | | | | | | | | | | | | 2.7 |
| **NET AREA** | **23.9** | **0.0** | **0.0** | **0.0** | **0.0** | **0.0** | **0.0** | **0.0** | **0.0** | **0.0** | **0.0** | **0.0** | **23.9** |
| No Harvest Zone (NHZ) | 0.0 | | | | | | | | | | | | 0.0 |
| Riparian Reserve (RRZ) | 0.0 | | | | | | | | | | | | 0.0 |
| Wildlife Tree Retention Area (WTRA) | 2.9 | | | | | | | | | | | | 2.9 |
| Reserve (RES) | 0.0 | | | | | | | | | | | | 0.0 |
| Roads (NPunn) | 1.9 | | | | | | | | | | | | 1.9 |
| NPImmature (NPNat) | 1.2 | | | | | | | | | | | | 1.2 |
| Trails (NPunn) | 0.1 | | | | | | | | | | | | 0.1 |
| NPRock (NPNat) | 6.3 | | | | | | | | | | | | 6.3 |
| **GROSS BLOCK AREA** | **36.3** | **0.0** | **0.0** | **0.0** | **0.0** | **0.0** | **0.0** | **0.0** | **0.0** | **0.0** | **0.0** | **0.0** | **36.3** |

Block Boundary
Adjacent Block Boundary
Stratum S.U. Boundary
Treatment Unit Boundary
Forest Cover Type Line
Wildlife Tree Retention Area (WHA)
Wildlife Habitat Area
Intermediate Contour
Index Contour
Falling Corner / Station
Cruise POC/ Drop Plot
Measure Plot/ Count Plot
Cruise Grid Tie Point

Highway's Road
Existing Road
Tolko or Interfor Existing Road
Upgrade Perm road LT
New Construction Perm LT
New Construction Temp ST
Upgrade Temp Road
Existing Trail
Permanent Trail
Temporary Trail
Existing Landing/Tower
Proposed Landing/Tower
Temporary Landing/Tower

OGMA
Existing Heli Landing
Proposed Heli Landing
Temporary Heli Landing
Culvert / Sized x100 (Exist./Prop.)
Skid Crossing/Skid Bridge
Skid Crossing/Skid Culvert
Bridge (Exist./Prop.)
Embankment
Rock Outcrop
Gully
Ridge
Wet Draw

Private Land
Riparian Management Zone
Riparian Reserve Zone
No Machine Zone
No Harvest Zone
Immature/Mature Leave
Long Term Retention
Stream
Stream Classification/ID. (S6-10)
Non Classified Drainage
Lake
Wetland (Class) (W3)

Swamp/ Seepage Areas
Reference Tree
Blowdown
Slope (20)
Slide
Avalanche Chute
Utility Line / Pipeline
Railroad
Fence
Cattleguard
Gate
NPnat
NPImm